

PIKE  
E103  
9-11-69

MISSISSIPPI  
BOARD OF WATER COMMISSIONERS  
416 North State Street  
Jackson, Mississippi 39201

**CODED**

WATER WELL DRILLERS LOG

Sept 11 1969 *Deer well & pump* *Reke*  
date well completed firm name county well located

LANDOWNER: *Smithaint*  
*& Building Supply*  
*Waldumb.*  
(mailing address)

description of formations encountered	from	to
<i>Clay &amp; gravel</i>	<i>0</i>	<i>2.5</i>
<i>Red sand</i>	<i>2.5</i>	<i>4.7</i>
<i>Sea gravel &amp; sand</i>	<i>4.7</i>	<i>6.3</i>

WELL LOCATION:  
sec *31* T *3* N R *8* E  
*1/2* miles *E* of *Fernwood*  
(distance) (direction) (nearest town)

WELL PURPOSE: *Home*  
(home, irrigation, municipal, industrial)

- WELL COMPLETION DATA:
- (1) diameter (inches) *4"*
  - (2) total depth (feet) *63*
  - (3) static water level (feet) *73* below top of ground. *above*
  - (4) casing *Plastic bottom*  
(material) (depth)
  - \_\_\_\_\_ if telescope see back.  
(size)
  - (5) screen *10'* *53'*  
(length) (depth to top)  
*4"* *Plastic*  
(size) (material)
  - (6) pump *1/2 HP* *30*  
(HP) (yield gpm)  
*elect.*  
(type power)
  - (7) electric log *No*  
(yes or no)

**CODED**

(organization running log)

(8) how well bottom plugged  
*wooden plug*


DRILLERS REMARKS:  
*New location*

SEP 29 1969

MISS. BD. OF  
WATER COMMISSIONERS

If well telescopes please sketch and show depths.

GROUND LEVEL

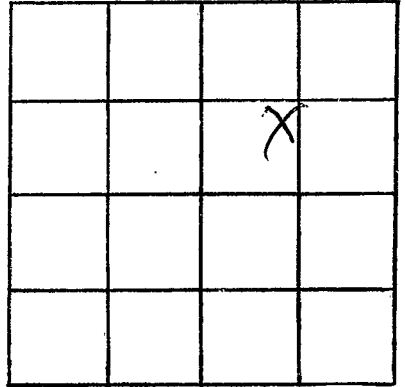

SECTION 31

Please indicate well location X.

ADDITIONAL INFORMATION

If more than one screen,  
show locations of each on sketch.