

Pike
E 104
9-17-69

MISSISSIPPI
 BOARD OF WATER COMMISSIONERS
 416 North State Street
 Jackson, Mississippi 39201

CODED

WATER WELL DRILLERS LOG

9-17 1969 Fitzgerald Hill Pike
 date well completed firm name county well located

LANDOWNER: Spat Martin
R.R. McComb Jones
 (mailing address)
 WELL LOCATION:
 sec. 12 T 3 N R 8 E
6 miles E of McComb
 (distance) (direction) (nearest town)
 WELL PURPOSE: Home
 (home, irrigation, municipal, industrial)

description of formations encountered	from	to
<u>Red clay</u>	<u>0</u>	<u>20</u>
<u>Red sand</u>	<u>20</u>	<u>70</u>
<u>Red gravel</u>	<u>70</u>	<u>100</u>
<u>Red sand</u>	<u>100</u>	<u>120</u>
<u>Coarse sand & gravel</u>	<u>120</u>	<u>133</u>

WELL COMPLETION DATA:
 (1) diameter (inches) 4
 (2) total depth (feet) 133
 (3) static water level (feet) 70 below top of ground.
 (4) casing Plastic, 125
 (material) (depth)
4 if telescope see back.
 (size)
 (5) screen 8, 125
 (length) (depth to top)
4, plastic
 (size) (material)
 (6) pump 1/2, 12
 (HP) (yield gpm)
elec
 (type power)
 (7) electric log no
 (yes or no)
 (organization running log)
 (8) how well bottom plugged wood plug

CODED

10/20 1969


MISS. DD. 62
 WATER COM. 1969

DRILLERS REMARKS:

MISS. DD. 62
 WATER COM. 1969

If well telescopes please sketch and show depths.

GROUND LEVEL

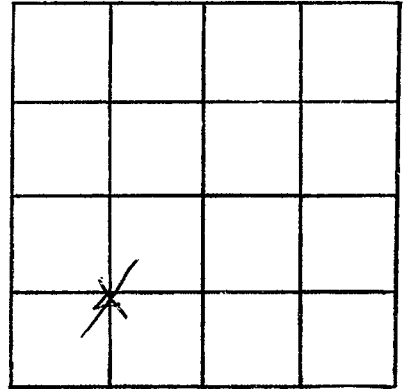

SECTION 12

Please indicate well location X.

ADDITIONAL INFORMATION

If more than one screen, show locations of each on sketch.