

Pike
E 106
9-25-69

MISSISSIPPI
BOARD OF WATER COMMISSIONERS
416 North State Street
Jackson, Mississippi 39201

CODED

WATER WELL DRILLERS LOG

Sept. 25 1969 Reynolds Well Drilling Pike
date well completed firm name county well located

LANDOWNER: Chester Jones
Rt 2 - McLamb
(mailing address)

description of formations encountered	from	to
<u>Red clay</u>	<u>0</u>	<u>2.5</u>
<u>Red sand</u>	<u>2.5</u>	<u>8.5</u>
<u>gravel</u>	<u>8.5</u>	<u>100</u>

WELL LOCATION:
sec. 10 T. 3 N R. 8 E
3/4 miles ESE of McLamb
(distance) (direction) (nearest town)

WELL PURPOSE: farm
(home, irrigation, municipal, industrial)

- WELL COMPLETION DATA:
- (1) diameter (inches) 4
 - (2) total depth (feet) 100
 - (3) static water level (feet) 65 ^{below} ~~above~~ top of ground.
 - (4) casing Plastic bottom
(material) (depth)
 - (size) if telescope see back.
 - (5) screen 6' 94'
(length) (depth to top)
4" Plastic
(size) (material)
 - (6) pump None
(HP) (yield gpm)
 - (type power)
 - (7) electric log No
(yes or no)
 - (organization running log)

CODED

(8) how well bottom plugged
wooden plug


DRILLERS REMARKS:
New location

DEC 31 1969

MISS. BD. OF
WATER COMMISSIONERS

If well telescopes please sketch and show depths.

GROUND LEVEL

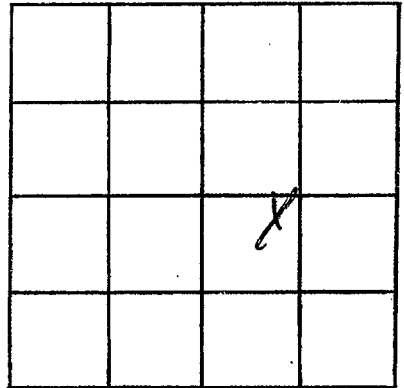

SECTION LO

Please indicate well location X.

ADDITIONAL INFORMATION

If more than one screen,
show locations of each on sketch.