

PIKE  
E 107  
12-22-69

MISSISSIPPI  
BOARD OF WATER COMMISSIONERS  
416 North State Street  
Jackson, Mississippi 39201

**CODED**

WATER WELL DRILLERS LOG

Dec 22 1969 Reynolds & Thompson Co. Pike  
date well completed firm name county well located

LANDOWNER: Rhoda Crockett  
Rt-1  
M. Clamb  
(mailing address)

description of formations encountered	from	to
clay	0	26
Red Sand	26	44
Dark gravel	44	95
Coarse Sand	95	109

WELL LOCATION:  
sec 32 T 3 N R 8 E  
1/4 miles S.E. of Farmers  
(distance) (direction) (nearest town)

WELL PURPOSE: Home  
(home, irrigation, municipal, industrial)

WELL COMPLETION DATA:

- (1) diameter (inches) 4"
- (2) total depth (feet) 109
- (3) static water level (feet) 85 below top of ground above
- (4) casing Plastic bottom  
(material) (depth)
- (size) if telescope see back.
- (5) screen 6' 103  
(length) (depth to top)
- 4" Plastic  
(size) (material)
- (6) pump old Reynolds  
(HP) (yield gpm)
- Clark  
(type power)
- (7) electric log NO  
(yes or no)
- (organization running log)

**CODED**

(8) how well bottom plugged wooden plug


JAN - 9 1970

DRILLERS REMARKS:  
old 2" well bore

MISSISSIPPI  
BOARD OF WATER COMMISSIONERS  
416 NORTH STATE STREET  
JACKSON, MISSISSIPPI 39201

If well telescopes please sketch and show depths.

GROUND LEVEL

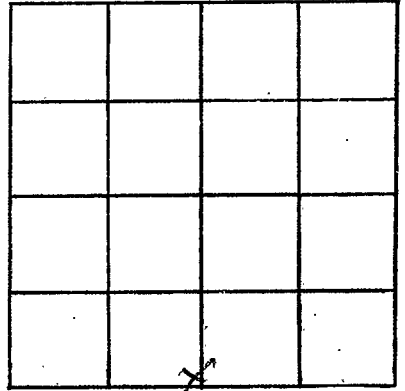

SECTION 32

Please indicate well location X.

ADDITIONAL INFORMATION

If more than one screen,  
show locations of each on sketch.