

PIKE
E 108
12-26-69

MISSISSIPPI
BOARD OF WATER COMMISSIONERS
416 North State Street
Jackson, Mississippi 39201

CODED

WATER WELL DRILLERS LOG

Dec 26 1969 *Keweenaw Drillers* *Pike*
date well completed firm name county well located

LANDOWNER: *Bobby McKenzie - Rt 1, McComb*
(mailing address)

description of formations encountered	from	to
<i>Red clay</i>	<i>0</i>	<i>12</i>
<i>sand</i>	<i>12</i>	<i>25</i>
<i>small gravel</i>	<i>25</i>	<i>53</i>

WELL LOCATION:
sec. *29* T *3* N R *8* E
7 miles *ENE* of *Fernand*
(distance) (direction) (nearest town)

WELL PURPOSE: *home*
(home, irrigation, municipal, industrial)

- WELL COMPLETION DATA:
- (1) diameter (inches) *4 1/2"*
 - (2) total depth (feet) *55*
 - (3) static water level (feet) *46* below top of ground. ~~above~~
 - (4) casing *Plastic Bottom*
(material) (depth)
 - (size) if telescope see back.
 - (5) screen *6"* *49*
(length) (depth to top)
 - 4"* *Plastic*
(size) (material)
 - (6) pump *1/2* *14*
(HP) (yield gpm)
 - Electric*
(type power)
 - (7) electric log *no*
(yes or no)
 - (organization running log)

CODED

(8) how well bottom plugged
wooden plug


DRILLERS REMARKS:
New house

JAN 9 1970

MISSISSIPPI
BOARD OF WATER COMMISSIONERS

If well telescopes please sketch and show depths.

GROUND LEVEL

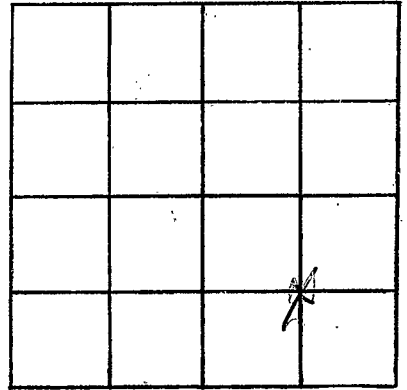

SECTION 29

Please indicate well location X.

ADDITIONAL INFORMATION

If more than one screen,
show locations of each on sketch.