

MISSISSIPPI
BOARD OF WATER COMMISSIONERS
416 North State Street
Jackson, Mississippi 39201

CODED

WATER WELL DRILLERS LOG

Dike
E109
9-26-69

Sept 26 1969 Keweenaw Well Drilling Co. Ltd Polk
date well completed firm name county well located

LANDOWNER: E. Arpewer
Rt 1, McComb

description of formations encountered	from	to
<u>Red clay</u>	<u>0</u>	<u>18</u>
<u>Red sand</u>	<u>18</u>	<u>80</u>
<u>Sand gravel</u>	<u>80</u>	<u>85</u>
<u>Red Clay sand</u>	<u>85</u>	<u>175</u>
<u>Red gravel sand</u>	<u>175</u>	<u>190</u>

(mailing address)

WELL LOCATION:
sec 3 T 3 N R 8 E
1/4 miles E of McComb
(distance) (direction) (nearest town)

WELL PURPOSE: Fish Pond
(home, irrigation, municipal, industrial)

WELL COMPLETION DATA:

- (1) diameter (inches) 4"
- (2) total depth (feet) 190
- (3) static water level (feet) 72 ^{below} ~~above~~ top of ground.
- (4) casing Plastic bottom
(material) (depth)
- (5) screen 16' - 174'
(length) (depth to top)
4" Plastic
(size) (material)
- (6) pump 1 23
(HP) (yield gpm)
Elect.
(type power)
- (7) electric log No.
(yes or no)

if telescope see back.
(size)

(organization running log)

(8) how well bottom plugged wood plug

CODED


DEC 31 1969

DRILLERS REMARKS:

MISS. BD. OF
WATER CONTROL

If well telescopes please sketch and show depths.

GROUND LEVEL

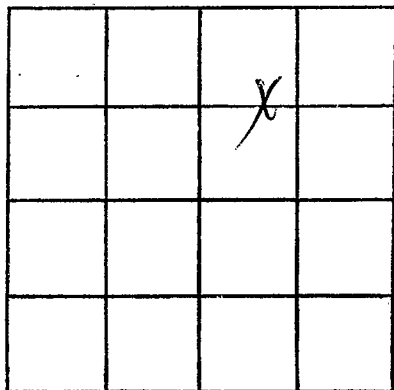

SECTION 3

Please indicate well location X.

ADDITIONAL INFORMATION

If more than one screen,
show locations of each on sketch.