

Pike
E 110
11-22-69

MISSISSIPPI
BOARD OF WATER COMMISSIONERS
416 North State Street
Jackson, Mississippi 39201

CODED

WATER WELL DRILLERS LOG

Nov 22 1969 Reverend Springs - Pike
date well completed firm name county well located

LANDOWNER: Melvin
Farrham
Rt-1, McLamb
(mailing address)

WELL LOCATION:
sec. 13 T-3 N R-6 E
6 miles SSE of McLamb
(distance) (direction) (nearest town)

WELL PURPOSE: Home
(home, irrigation, municipal, industrial)

WELL COMPLETION DATA:

- (1) diameter (inches) 4"
- (2) total depth (feet) 176
- (3) static water level (feet) 114 below above top of ground.
- (4) casing Plastic Babbitt
(material) (depth)
- (size) if telescope see back.
- (5) screen 6' 170
(length) (depth to top)
4" elastic
(size) (material)
- (6) pump 3/4 HP 12
(HP) (yield gpm)
Electric
(type power)
- (7) electric log No
(yes or no)
- (organization running log)
- (8) how well bottom plugged wooden plug

description of formations encountered	from	to
Red clay	0	22
Red sand & gravel	22	82
fine pink sand	82	165
coarse sand	165	176

CODED


DRILLERS REMARKS:
New location

DEC 31 1969

MISSISSIPPI
BOARD OF WATER COMMISSIONERS
416 NORTH STATE STREET
JACKSON, MISSISSIPPI 39201

If well telescopes please sketch and show depths.

GROUND LEVEL

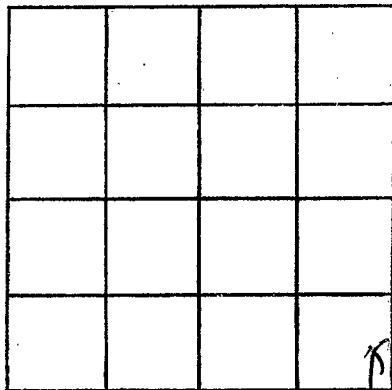

SECTION 13

Please indicate well location X.

ADDITIONAL INFORMATION

If more than one screen, show locations of each on sketch.