

PIKE
E112
10-20-69

MISSISSIPPI
BOARD OF WATER COMMISSIONERS
416 North State Street
Jackson, Mississippi 39201

CODED

WATER WELL DRILLERS LOG

10-20-69 date well completed 19 69 firm name Fitzgould well serv Pike county well located

LANDOWNER: Lora Catt
R.R. McComb, Miss.
(mailing address)
WELL LOCATION:
sec 38 T 3 (N) R 8 (E) W
2 miles E of McComb
(distance) (direction) (nearest town)

description of formations encountered	from	to
<u>Red chalk</u>	<u>6</u>	<u>20</u>
<u>Red sand</u>	<u>20</u>	<u>60</u>
<u>Red gravel</u>	<u>60</u>	<u>70</u>
<u>Coarse sand</u>	<u>70</u>	<u>92</u>
<u>White clay</u>	<u>92</u>	<u>106</u>

WELL PURPOSE: Home
(home, irrigation, municipal, industrial)

WELL COMPLETION DATA:
(1) diameter (inches) 4
(2) total depth (feet) 106
(3) static water level (feet) 50 below top of ground.
(4) casing Plastic 0-8 7/8, 92-106
(material) (depth)
4 if telescope see back.
(size)
(5) screen 6 , 87
(length) (depth to top)
4 , plastic
(size) (material)
(6) pump 1/2 , 1.2
(HP) (yield gpm)
Electric
(type power)
(7) electric log no
(yes or no)
(organization running log)
(8) how well bottom plugged wood plug

CODED


NOV 21 1969

DRILLERS REMARKS:

MADE BY DR
WATER CONTR

If well telescopes please sketch and show depths.

GROUND LEVEL

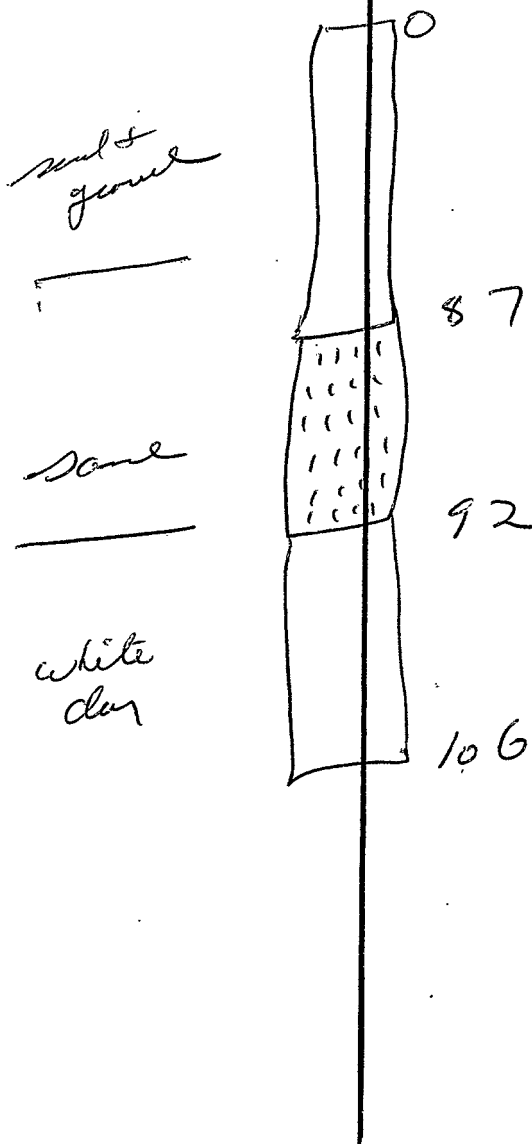

			X

SECTION 28

Please indicate well location X.

ADDITIONAL INFORMATION

If more than one screen,
show locations of each on sketch.