

PIKE
E 114
2-10-71

MISSISSIPPI
BOARD OF WATER COMMISSIONERS
416 North State Street
Jackson, Mississippi 39201

CODED

WATER WELL DRILLERS LOG

2-10 date well completed 19 71 firm name Fitzgerald Well Serv Co. county well located Pike

LANDOWNER:
Marilyn Dickerson
P.O. M'Comb Miss.
(mailing address)

| description of formations encountered | from | to |
|---------------------------------------|------|-----|
| Red Clay | 0 | 20 |
| Red gravel | 20 | 80 |
| White Clay | 80 | 130 |
| Fine Sand | 130 | 150 |
| Coarse Sand | 150 | 163 |

WELL LOCATION:
sec. 14 T 30 N R 7 E
S W
6 miles E of M'Comb
(distance) (direction) (nearest town)

WELL PURPOSE: Home
(home, irrigation, municipal, industrial)

- WELL COMPLETION DATA:
- (1) diameter (inches) 4
 - (2) total depth (feet) 163
 - (3) static water level (feet) 90 below top of ground.
 - (4) casing Plastic 157 (material) (depth)
4 (size) If telescope see back.
 - (5) screen 6 157 (length) (depth to top)
4 Plastic (size) (material)
 - (6) pump 1/2 10 (HP) (yield gpm)
6 (type power)
 - (7) electric log no (yes or no)

CODED

(organization running log)
(8) how well bottom plugged *closed*


MAR 5 - 1971

DRILLERS REMARKS:

MISS. BD. OF
WATER COMM.

If well telescopes please sketch and show depths.

GROUND LEVEL

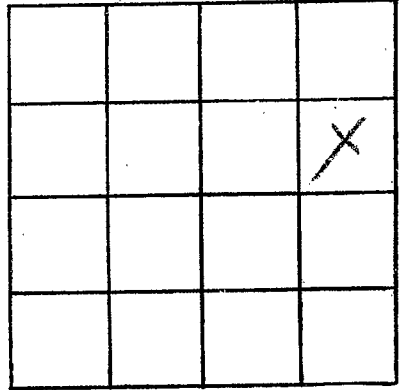

SECTION 14

Please indicate well location X.

ADDITIONAL INFORMATION

If more than one screen, show locations of each on sketch.