

PIKE WATER WELL DRILLERS LOG **CODED**
E 115

Date: 7-11-63 1963, Driller Chester Deane County Pike
CODED 7-11-63 (Name)

(1) Owner of Land: Charles Brown
RFD 1, M. Camb.
(Name) (Address)
(2) Location: 1/4, 1/4, Sec. 4 T3R8
3 1/2 miles EAST of M. Camb.
(distance) (direction) (Nearest Town)
(3) Topography: Hilly
(Hilly) (Flat) (Level)
(4) Purpose of Well: Domestic
(Domestic Irrigation, Municipal, Industrial, Other)

Description & Color of Materials Sand, Clay, Red Clay, Shell, etc.	Thick- ness Feet	Dep- th Feet
<u>Red clay</u>	<u>10</u>	<u>10</u>
<u>Red sand</u>	<u>50</u>	<u>60</u>
<u>white chalk</u>	<u>40</u>	<u>100</u>
<u>fine brown sand</u>	<u>10</u>	<u>110</u>
<u>white chalk</u>	<u>30</u>	<u>140</u>
<u>Sand</u>	<u>30</u>	<u>170</u>


Information upon completion of well:

(1) Diameter 4 inches.
(2) Total Depth 170 feet.
(3) Water Level 70 feet below top of ground.
(4) Cased to Bottom size 4
(5) Screen: Size 1/4", Length 10'
(6) Were any formations sealed against pollution?
_____ yes, no.

If YES depth of formation _____

Why _____

Drillers Remarks: good well
Bad

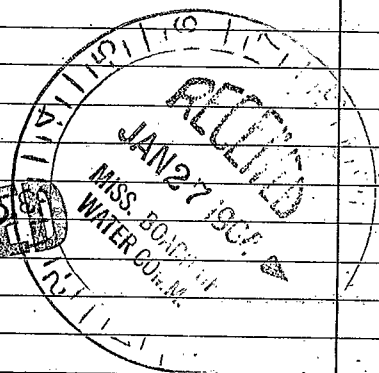

REEVES WELL & PUMP CO.
P. O. BOX 71 - PHONE 684-1451
McCOMB, MISS.

(Use Back Side)

Well No.

