

MISSISSIPPI  
BOARD OF WATER COMMISSIONERS  
416 North State Street  
Jackson, Mississippi 39201

**CODED**

WATER WELL DRILLERS LOG

Pike  
E-116  
8-20-71

8-20-1971 date well completed Harmer Drilling Service firm name Pike county well located

LANDOWNER: MFC Services  
Adams Poultry Co.  
McComb, Miss.  
(mailing address)

WELL LOCATION: SW 1/4 SE  
sec. 19 T. 30 N. R. 8 E  
S W  
\_\_\_\_\_ miles \_\_\_\_\_ of \_\_\_\_\_  
(distance) (direction) (nearest town)

WELL PURPOSE:  
(home, irrigation, municipal, industrial)

WELL COMPLETION DATA:

- (1) diameter (inches) 8 5/8
- (2) total depth (feet) 688
- (3) static water level (feet) 186  below  above top of ground.
- (4) casing B.I. 630  
(material) (depth)
- 8 5/8  
(size) If telescope see back.
- (5) screen 40 644  
(length) (depth to top)
- 6 304 SS.  
(size) (material)
- (6) pump 20 153  
(HP) (yield gpm)
- Elect  
(type power)
- (7) electric log yes  
(yes or no)
- MGS  
(organization running log)
- (8) how well bottom plugged Backward  
value

description of formations encountered	from to	
<del>Top Soil</del>	<del>7</del>	<del>2</del>
<del>Coarse Sand &amp; Gravel</del>	<del>2</del>	<del>120</del>
<del>Clay</del>	<del>120</del>	<del>160</del>
<del>Sand</del>	<del>160</del>	<del>294</del>
<del>Clay</del>	<del>294</del>	<del>336</del>
<del>Sand</del>	<del>336</del>	<del>370</del>
<del>Clay</del>	<del>370</del>	<del>628</del>
<del>Sand</del>	<del>628</del>	<del>714</del>

Log

Top Soil	0	2
Coarse Sand + Gravel	2	120
Clay	120	160
Sand	160	294
Clay	294	336
Sand	336	370
Clay	370	628
Sand	628	714

**CODED**

SEP 2 1971


MISS. BD. OF  
WATER C.

DRILLERS REMARKS:  
Top of Lap - 604

5

If well telescopes please sketch and show depths.

GROUND LEVEL

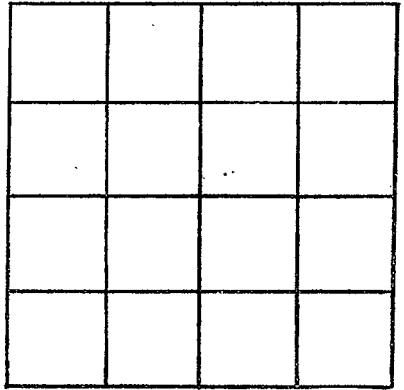

SECTION \_\_\_\_\_

Please indicate well location X.

ADDITIONAL INFORMATION

A series of horizontal lines for recording additional information.

If more than one screen, show locations of each on sketch.