

Pike
E-118
8-3-71

MISSISSIPPI
BOARD OF WATER COMMISSIONERS
416 North State Street
Jackson, Mississippi 39201

CODED

WATER WELL DRILLERS LOG

8-3 1971 Felguth Well Dr Pike
date well completed firm name county well located

LANDOWNER:	description of formations encountered	from	to
<u>Chlorine Mays</u> <u>P.R. McComb Min.</u> (mailing address)	<u>Red clay</u> <u>Red sand</u> <u>White clay</u> <u>Coarse red & gravel</u>	<u>0</u> <u>20</u> <u>80</u> <u>115</u>	<u>20</u> <u>80</u> <u>115</u> <u>128</u>
<p>WELL LOCATION:</p> <p>sec. <u>35</u> T. <u>3</u> N. R. <u>8</u> E. S. W.</p> <p><u>7</u> miles <u>E</u> of <u>McComb</u> (distance) (direction) (nearest town)</p>			
<p>WELL PURPOSE: <u>Home</u> (home, irrigation, municipal, industrial)</p>			
<p>WELL COMPLETION DATA:</p> <p>(1) diameter (inches) <u>4</u></p> <p>(2) total depth (feet) <u>128</u></p> <p>(3) static water level (feet) <u>95</u> below above top of ground.</p> <p>(4) casing <u>plastic</u> <u>120</u> (material) (depth) <u>4</u> if telescope see back. (size)</p> <p>(5) screen <u>8</u> <u>120</u> (length) (depth to top) <u>4</u> <u>plastic</u> (size) (material)</p> <p>(6) pump <u>1/2</u> <u>10</u> (HP) (yield gpm) <u>Electric</u> (type power)</p> <p>(7) electric log <u>no</u> (yes or no) <u>McComb Min.</u> (organization running log)</p>			
<p>(8) how well bottom plugged <u>Goodly</u></p>			
<p>DRILLERS REMARKS:</p>			


CODED

AUG 11 1971

MISS. BD. OF
WATER COMMISSIONERS

If well telescopes please sketch and show depths.

GROUND LEVEL

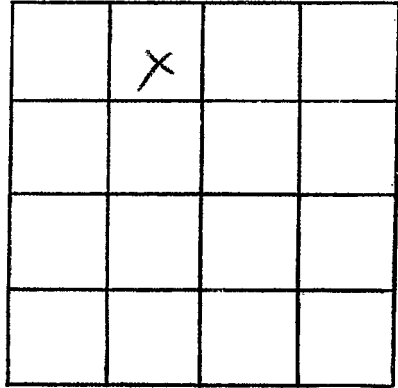

SECTION 35

Please indicate well location X.

ADDITIONAL INFORMATION

If more than one screen,
show locations of each on sketch.