

Pike
E 122
10-6-71

MISSISSIPPI
BOARD OF WATER COMMISSIONERS
416 North State Street
Jackson, Mississippi 39201

28 1971

WATER WELL DRILLERS LOG

CODED
Pike

get 6 1971 date well completed
Chester Reeves firm name
Pike county well located

LANDOWNER: Paul Dickerson
H.C. McComb
(mailing address)

description of formations encountered	from	to
Red clay	0	18
Red Sand	18	72
Sand & gravel	72	117
Red chalk Sand	117	126
gravel & Sand	126	146

WELL LOCATION:
sec. 13 T 3 N R 8 E
5 miles ESE of McComb
(distance) (direction) (nearest town)

WELL PURPOSE: Home
(home, irrigation, municipal, industrial)

- WELL COMPLETION DATA:
- (1) diameter (inches) 4"
 - (2) total depth (feet) 146
 - (3) static water level (feet) 102 below top of ground
 - (4) casing Plast. Ballium
(material) (depth)
(size) If telescope see back.
 - (5) screen 6' 140'
(length) (depth to top)
Plast
(size) (material)
 - (6) pump 3/4 Sub 12
(HP) (yield gpm)
elect
(type power)
 - (7) electric log No
(yes or no)
- (organization running log)


CODED

(8) how well bottom plugged
wooden Plug

DRILLERS REMARKS:
New House

If well telescopes please sketch and show depths.

GROUND LEVEL

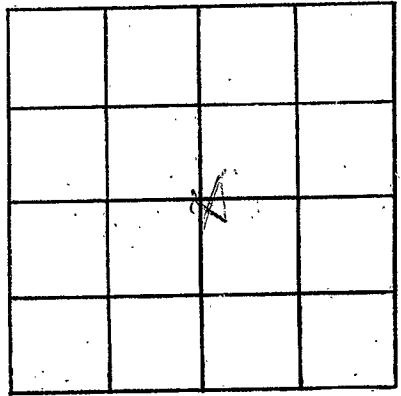

SECTION 13

Please indicate well location X.

ADDITIONAL INFORMATION

If more than one screen,
show locations of each on sketch.