

Pike
E 123
10-7-71

MISSISSIPPI
BOARD OF WATER COMMISSIONERS
416 North State Street
Jackson, Mississippi 39201

FILE 28 1971

WATER WELL DRILLERS LOG **CODED**

oct 7 1971 chester keenes pike
date well completed firm name county well located

LANDOWNER: Leroy Layton
Rt 1, McClemb

description of formations encountered	from	to
Red clay	0	2.7
Red sand	2.7	6.5
Small gravel sand	6.5	10.5
white chalk	10.5	12.5
Coarse sand	12.5	15.2

(mailing address)

WELL LOCATION:
sec. 12 T 3 N R 4 E
4 1/2 miles E of McClemb
(distance) (direction) (nearest town)

WELL PURPOSE: Home well
(home, irrigation, municipal, industrial)

- WELL COMPLETION DATA:
- (1) diameter (inches) 4"
 - (2) total depth (feet) 15.2
 - (3) static water level (feet) 11.2 below top of ground.
 - (4) casing Plast Bottom
(material) (depth)
 - (size) if telescope see back.
 - (5) screen 6' 146'
(length) (depth to top)
 - 4" Plast
(size) (material)
 - (6) pump 3/4 Sub 1 1/2
(HP) (yield gpm)
 - plast
(type power)
 - (7) electric log no
(yes or no)

CODED


(organization running log)

(8) how well bottom plugged
wooden plug

DRILLERS REMARKS:
New well

If well telescopes please sketch and show depths.

GROUND LEVEL

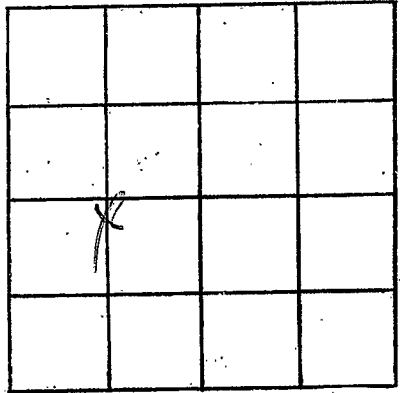

SECTION 12

Please indicate well location X.

ADDITIONAL INFORMATION

If more than one screen, show locations of each on sketch.