

MISSISSIPPI
 BOARD OF WATER COMMISSIONERS
 416 North State Street
 Jackson, Mississippi 39201

WATER WELL DRILLERS LOG

CODED

Pike
 E 124
 10-13-71

date well completed 1971 firm name Chester Keene county well located Pike

LANDOWNER: Alma Johnson
 Fernwood
 (mailing address)

description of formations encountered

from to

clay	0	4
sand	4	30
chalk	30	35
Sand & gravel	35	70

WELL LOCATION:

sec. 30 T 3 N R 8 E
 1 miles NE of Fernwood
 (distance) (direction) (nearest town)

WELL PURPOSE: Household
 (home, irrigation, municipal, industrial)

WELL COMPLETION DATA:

- (1) diameter (inches) 4
- (2) total depth (feet) 70
- (3) static water level (feet) 35 below top of ground
- (4) casing Plast. galv. (material) 35 (depth)
 (size) if telescope see back.
- (5) screen 6' (length) 64' (depth to top)
Plast. (material)
- (6) pump 1/2 HP (HP) 15 (yield gpm)
elect (type power)
- (7) electric log not (yes or no)

CODED


(organization running log)

(8) how well bottom plugged wooden plug

DRILLERS REMARKS: old well had

If well telescopes please sketch and show depths.

GROUND LEVEL

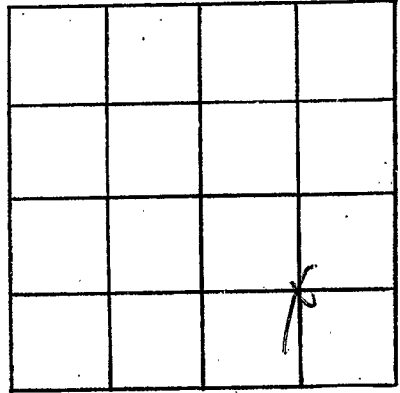

SECTION 30

Please indicate well location X.

ADDITIONAL INFORMATION

If more than one screen, show locations of each on sketch.