

MISSISSIPPI
 BOARD OF WATER COMMISSIONERS
 416 North State Street
 Jackson, Mississippi 39201

WATER WELL DRILLERS LOG

CODED

Pike
 E 125
 10-14-71

Oct 14 1971 date well completed
 Chestnut Haven firm name
 Pike county well located

LANDOWNER

Keith Bonds
 Fernwood

description of formations encountered

from to

sand & gravel	0	20
Sand	20	30
cherty sand	30	40
Sand & gravel	40	80

(mailing address)

WELL LOCATION:

sec. 37 T 3 N R 8 E
 1 1/2 miles SE of Fernwood
 (distance) (direction) (nearest town)

WELL PURPOSE: Drinking
 (home, irrigation, municipal, industrial)

WELL COMPLETION DATA:

- (1) diameter (inches) 4"
- (2) total depth (feet) 80
- (3) static water level (feet) 65 below top of ground
- (4) casing cast iron
 (material) (depth)
- (size) if telescope see back.
- (5) screen 6' 74'
 (length) (depth to top)
- (size) (material) cast
- (6) pump 1/2 sub 15
 (HP) (yield gpm)
- (type power) elec
- (7) electric log no
 (yes or no)

CODED


(organization running log)

(8) how well bottom plugged
working plug

DRILLERS REMARKS:
old well pad

If well telescopes please sketch and show depths.

GROUND LEVEL

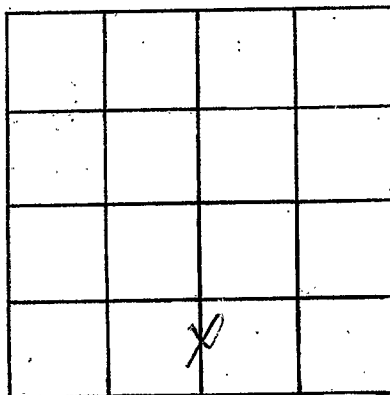

SECTION 32

Please indicate well location X.

ADDITIONAL INFORMATION

If more than one screen, show locations of each on sketch.