

Pike
E 126
10-15-71

MISSISSIPPI
BOARD OF WATER COMMISSIONERS
416 North State Street
Jackson, Mississippi 39201

CODED

WATER WELL DRILLERS LOG

Oct 15 1971 *Chet McKee* *Pike*
date well completed firm name county well located

LANDOWNER: *Small*
Cathron
Hz. McDomb
(mailing address)

description of formations encountered	from	to
<i>clay</i>	<i>0</i>	<i>10</i>
<i>sand</i>	<i>10</i>	<i>70</i>
<i>sand & gravel</i>	<i>70</i>	<i>80</i>
<i>super sand</i>	<i>80</i>	<i>84</i>
<i>sand</i>	<i>84</i>	<i>97</i>

WELL LOCATION:
sec. *30* T. *3* N. R. *8* E
6 miles *SE* *McDomb*
(distance) (direction) (nearest town)

WELL PURPOSE: *Home*
(home, irrigation, municipal, industrial)

WELL COMPLETION DATA:

(1) diameter (inches) *4"*

(2) total depth (feet) *97*

(3) static water level (feet) *55* below top of ground. *above*

(4) casing *Plast. Bottoms*
(material) (depth)

(size) If telescope see back.

(5) screen *6'* *91'*
(length) (depth to top)

1 1/2" *Plast.*
(size) (material)

(6) pump *1/2 HP* *100 gph*
(HP) (yield gph)

(type power)

(7) electric log *no*
(yes or no)

(organization running log)


CODED

(8) how well bottom plugged *wooden plug*

DRILLERS REMARKS: *old well bad*

If well telescopes please sketch and show depths.

GROUND LEVEL

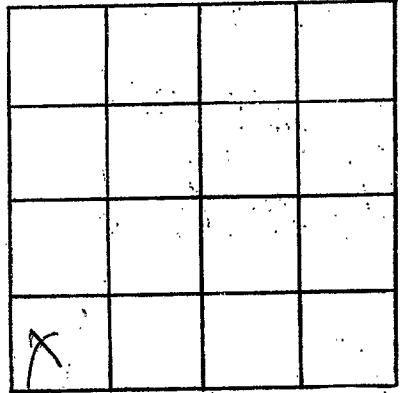

SECTION 36

Please indicate well location X.

ADDITIONAL INFORMATION

If more than one screen, show locations of each on sketch.