

Pike
E 127
1-5-72

MISSISSIPPI
BOARD OF WATER COMMISSIONERS
416 North State Street
Jackson, Mississippi 39201

WATER WELL DRILLERS LOG

CODED

1-5 1972 Fitzgerald Well Dr. Pike
date well completed firm name county well located

LANDOWNER:	description of formations encountered	from	to
George Reeves	Red clay	6	20
R.R. McComb, Min. (mailing address)	Red sand & gravel	20	110
WELL LOCATION: sec. 15 T. 3 N S R. 8 E	Red sand	110	150
5 miles E of McComb (distance) (direction) (nearest town)	Coarse sand & gravel	150	160
WELL PURPOSE: Home (home, irrigation, municipal, industrial)			
WELL COMPLETION DATA:			
(1) diameter (inches) 4			
(2) total depth (feet) 160			
(3) static water level (feet) 110 below top of ground.			
(4) casing 1 1/2" (material) 152 (depth)			
4" (size) If telescope see back.			
(5) screen 8" (length) 152 (depth to top)			
4" (size) 1 1/2" (material)			
(6) pump 1/2 (HP) 8 (yield gpm)			
Electric (type power)			
(7) electric log No (yes or no)			
(organization running log)			
(8) how well bottom plugged gravel			
DRILLERS REMARKS:			


CODED

JAN 10 1972

MISS. BD. OF
WATER COMM.

If well telescopes please sketch and show depths.

GROUND LEVEL

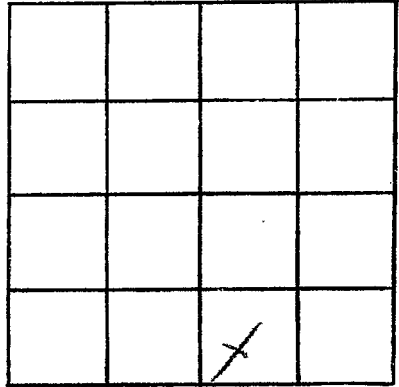

SECTION 15

Please indicate well location X.

ADDITIONAL INFORMATION

If more than one screen,
show locations of each on sketch.