

Pike
E128
12-23-71

MISSISSIPPI
BOARD OF WATER COMMISSIONERS
416 North State Street
Jackson, Mississippi 39201

CODED

WATER WELL DRILLERS LOG

12-23-1971 F. L. Goodwell, Inc. Pike
date well completed firm name county well located


LANDOWNER:	description of formations encountered	from	to
<u>Tommy Bellack</u> <u>P.R. McComb, Miss.</u> (mailing address)	<u>Red Clay</u> <u>Red gravel</u> <u>Red Sand</u>	<u>0</u> <u>20</u> <u>70</u>	<u>20</u> <u>70</u> <u>130</u>
WELL LOCATION: sec. <u>27</u> T. <u>3</u> N. R. <u>8</u> E <u>6</u> miles <u>E</u> of <u>McComb</u> (distance) (direction) (nearest town)	<u>Green sand & gravel</u>	<u>130</u>	<u>140</u>
WELL PURPOSE: <u>Flow</u> (home, irrigation, municipal, industrial)			
WELL COMPLETION DATA: (1) diameter (inches) <u>4</u> (2) total depth (feet) <u>140</u> (3) static water level (feet) <u>105</u> Below above top of ground. (4) casing <u>plastic</u> <u>132</u> (material) (depth) <u>4</u> If telescope see back. (size) (5) screen <u>8</u> <u>132</u> (length) (depth to top) <u>4</u> <u>plastic</u> (size) (material) (6) pump <u>1</u> <u>6</u> (HP) (yield gpm) <u>Clear</u> (type power) (7) electric log <u>no</u> (yes or no) (organization running log) (8) how well bottom plugged <u>wood plug</u>			
DRILLERS REMARKS:			

CODED

JAN 18 1972
MISS. BD. OF
WATER COM.

If well telescopes please sketch and show depths.

GROUND LEVEL

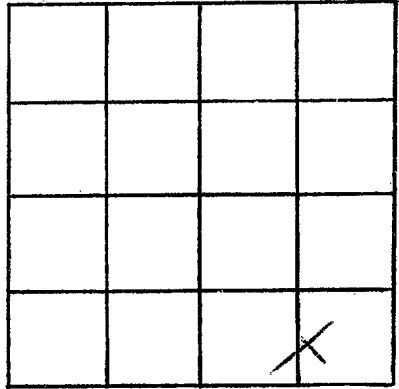

SECTION 27

Please indicate well location X.

ADDITIONAL INFORMATION

If more than one screen,
show locations of each on sketch.