

Pike
E130
2-22-72

MISSISSIPPI
 BOARD OF WATER COMMISSIONERS
 416 North State Street
 Jackson, Mississippi 39201

CODED

WATER WELL DRILLERS LOG

Feb 22 19 72 H. J. ... Pike
 date well completed firm name county well located


LANDOWNER:	description of formations encountered	from	to
<u>E. W. Magee</u>			
<u>R.R. ...</u> (mailing address)	<u>Red sand</u>	<u>30</u>	<u>70</u>
WELL LOCATION: sec <u>35</u> T <u>3</u> N R <u>8</u> E	<u>Red gravel</u>	<u>70</u>	<u>120</u>
<u>7</u> miles <u>SE</u> of <u>M. ...</u> (distance) (direction) (nearest town)	<u>Coarse sand gravel</u>	<u>120</u>	<u>142</u>
WELL PURPOSE: (home, irrigation, municipal, industrial)			
WELL COMPLETION DATA:			
(1) diameter (inches) <u>4</u>			
(2) total depth (feet) <u>142</u>			
(3) static water level (feet) <u>115</u> below top of ground.			
(4) casing <u>plastic</u> <u>134</u> (material) (depth)			
<u>4</u> (size) If telescope see back.			
(5) screen <u>8</u> <u>134</u> (length) (depth to top)			
<u>4</u> <u>plastic</u> (size) (material)			
(6) pump <u>1/2</u> <u>8</u> (HP) (yield gpm)			
<u>elec</u> (type power)			
(7) electric log <u>no</u> (yes or no)			
(organization running log)			
(8) how well bottom plugged <u>lined by</u>			
DRILLERS REMARKS:			

CODED

INFR 22 1972

If well telescopes please sketch and show depths.

GROUND LEVEL

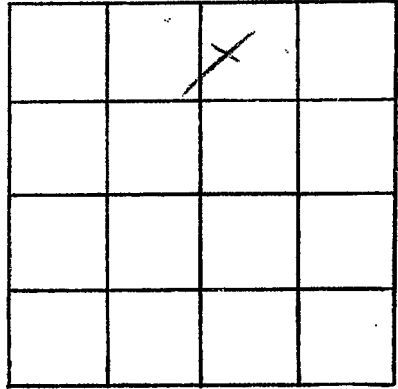

SECTION 35

Please indicate well location X.

ADDITIONAL INFORMATION

If more than one screen, show locations of each on sketch.