

MISSISSIPPI
BOARD OF WATER COMMISSIONERS
416 North State Street
Jackson, Mississippi 39201

CODED

WATER WELL DRILLERS LOG

Pike
E 132
2-24-72

February 1972 date well completed
Chester Keener firm name
Pike county well located

LANDOWNER: Robert
Creech
P.O. Box 100
McComb, Miss.
(mailing address)

description of formations encountered	from	to
Red clay	0	14
Red sand	14	38
Red sand - chert	38	94
Small gravel & sand	94	116

WELL LOCATION:
sec. 14 T. 3 N. R. 5 E
4 miles E of McComb
(distance) (direction) (nearest town)

WELL PURPOSE: Same
(home, irrigation, municipal, industrial)

- WELL COMPLETION DATA:
- (1) diameter (inches) 4"
 - (2) total depth (feet) 116
 - (3) static water level (feet) 83 below top of ground
 - (4) casing: Plastic, bottom (material) (depth)
 - (5) screen: 6' (length) 110 (depth to top)
4" (size) Plastic (material)
 - (6) pump: 1/2 Sub-12 (HP) (yield gpm)
Electric (type power)
 - (7) electric log: No (yes or no)

CODED

JUN 29 1972

(organization running log)


(8) how well bottom plugged
wooden plug

DRILLERS REMARKS:
"dell" well
bad.

MISS. B.D. 35
REGISTERED PROFESSIONAL

If well telescopes please sketch and show depths.

GROUND LEVEL

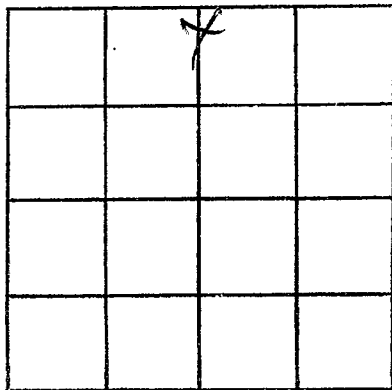

SECTION 14

Please indicate well location X.

ADDITIONAL INFORMATION

If more than one screen, show locations of each on sketch.