

Pike  
E 133  
3-3-72

MISSISSIPPI  
BOARD OF WATER COMMISSIONERS  
416 North State Street  
Jackson, Mississippi 39201

**CODED**

WATER WELL DRILLERS LOG

March 3 1972 Chester Beene Pike  
date well completed firm name county well located

LANDOWNER Samuel Beene  
St. Camb. Miss  
(mailing address)

description of formations encountered	from	to
Red clay	0	16
Red chert sand	16	79
gravel sand	79	87
cherty sand	87	105
sand	105	116

WELL LOCATION:  
sec. 5 T 7 N R 4 E  
1 miles E of St. Camb.  
(distance) (direction) (nearest town)

WELL PURPOSE: Home  
(home, irrigation, municipal, industrial)

WELL COMPLETION DATA:

- (1) diameter (inches) 4 1/2
- (2) total depth (feet) 116
- (3) static water level (feet) 70 below top of ground.
- (4) casing Plast Bottom  
(material) (depth)
- (size) if telescope see back.
- (5) screen 6' 110  
(length) (depth to top)
- (size) Plast  
(material)
- (6) pump 1/2 15  
(HP) (yield gpm)
- (type power) elec
- (7) electric log no  
(yes or no)

**CODED**

MAR 30 1972

MISS. PD. CE  
REGISTERED GEOLGIST


(organization running log)

(8) how well bottom plugged woodruff plug

DRILLERS REMARKS:  
old 2" well had

If well telescopes please sketch and show depths.

GROUND LEVEL

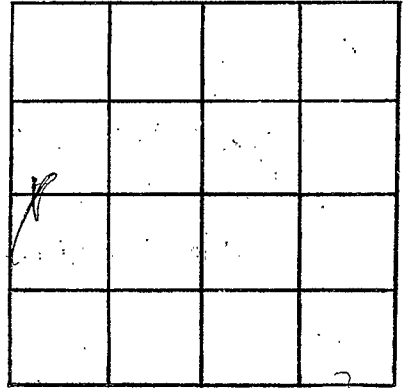

SECTION

Please indicate well location X.

ADDITIONAL INFORMATION

If more than one screen, show locations of each on sketch.