

Pike
E 134
5-9-72

MISSISSIPPI
BOARD OF WATER COMMISSIONERS
416 North State Street
Jackson, Mississippi 39201

CODED

WATER WELL DRILLERS LOG

9 May 1972 *S&P Water Well* PIKE
date well completed firm name county well located

LANDOWNER:	description of formations encountered	from	to
<i>Dudley Keffer</i>	<i>Clay</i>	<i>0</i>	<i>70</i>
<i>Summit</i>	<i>Clay Sand</i>	<i>70</i>	<i>100</i>
(mailing address)	<i>Sand</i>	<i>40</i>	<i>65</i>
WELL LOCATION:			
sec. <i>6</i> T <i>3</i> N R <i>8</i> E			
<i>1</i> miles <i>E</i> of <i>McComb</i>			
(distance) (direction) (nearest town)			
WELL PURPOSE:			
(home, irrigation, municipal, industrial)			
WELL COMPLETION DATA:			
(1) diameter (inches) <i>4</i>			
(2) total depth (feet) <i>65</i>			
(3) static water level (feet) <i>40</i> below top of ground			
(4) casing (material) <i>PI</i> , (depth) <i>59</i>			
_____ if telescope see back. (size)			
(5) screen (length) <i>6</i> , (depth to top) <i>59</i>			
_____ (size) _____ (material)			
(6) pump (HP) <i>1/2</i> , (yield gpm) <i>8</i>			
_____ (type power) <i>electric</i>			
(7) electric log _____ (yes or no)			
_____ (organization running log)			
(8) how well bottom plugged <i>Wood</i>			

DRILLERS REMARKS:			


CODED

MISS. Bd. of Water Comm. 25 10/72

MISS. Bd. of Water Comm. 25 10/72

If well telescopes please sketch and show depths.

GROUND LEVEL

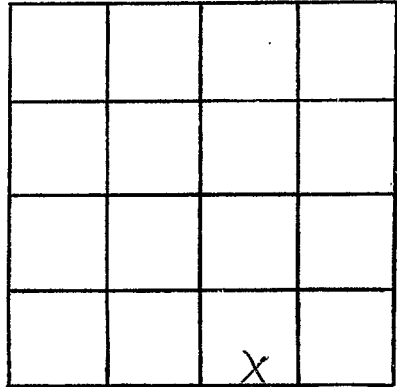

SECTION 12

Please indicate well location X.

ADDITIONAL INFORMATION

If more than one screen, show locations of each on sketch.