

Pike  
E135  
7-19-72

MISSISSIPPI  
BOARD OF WATER COMMISSIONERS  
416 North State Street  
Jackson, Mississippi 39201

**CODED**

WATER WELL DRILLERS LOG

7-19 1972 Fitzgerald Well Dr Pike  
date well completed firm name county well located

LANDOWNER:	description of formations encountered	from	to
<u>Jack Jones -</u> <u>R.R. McComb miss -</u> (mailing address)	<u>Red clay</u> <u>Red sand &amp; gravel</u> <u>Coarse sand &amp; gravel</u>	<u>0</u> <u>20</u> <u>50</u>	<u>20</u> <u>30</u> <u>85</u>
WELL LOCATION: sec. <u>4</u> T. <u>3</u> N. R. <u>8</u> E <u>3</u> miles <u>E</u> of <u>McComb</u> (distance) (direction) (nearest town)			
WELL PURPOSE: <u>Home</u> (home, irrigation, municipal, industrial)			
WELL COMPLETION DATA:			
(1) diameter (inches) <u>4</u>			
(2) total depth (feet) <u>85</u>			
(3) static water level (feet) <u>60</u> below top of ground.			
(4) casing <u>Plastic</u> <u>79</u> (material) (depth)			
<u>4</u> (size) if telescope see back.			
(5) screen <u>8</u> <u>79</u> (length) (depth to top)			
<u>4</u> (size) <u>Plastic</u> (material)			
(6) pump <u>1/2</u> <u>12</u> (HP) (yield gpm)			
<u>clear</u> (type power)			
(7) electric log <u>no</u> (yes or no)			
(organization running log)			
(8) how well bottom plugged <u>as well as</u>			
DRILLERS REMARKS:			


**CODED**

ADMG - 7 1972

MISSISSIPPI  
WATER COMMISSIONERS

If well telescopes please sketch and show depths.

GROUND LEVEL

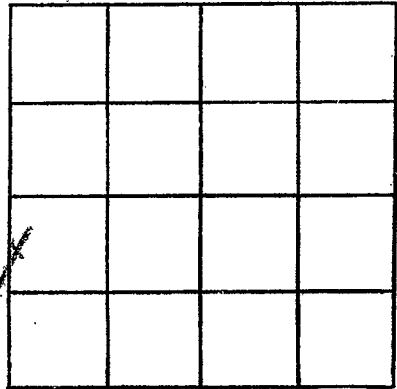

SECTION 7

Please indicate well location X.

ADDITIONAL INFORMATION

If more than one screen,  
show locations of each on sketch.