

MISSISSIPPI
 BOARD OF WATER COMMISSIONERS
 416 North State Street
 Jackson, Mississippi 39201

CODED

WATER WELL DRILLERS LOG

Pike
 E 136
 11-6-72

Nov 6 1972 date well completed
 Chester Reeves firm name
 Pike county well located

LANDOWNER: Ches Sautter
 Rt 3, McComb (mailing address)

WELL LOCATION:
 sec. 5 T 3 N R 6 E
 1 mile ENE of McComb (distance) (direction) (nearest town)

WELL PURPOSE: Drain
 (home, irrigation, municipal, industrial)

WELL COMPLETION DATA:
 (1) diameter (inches) 4 1/2"
 (2) total depth (feet) 71
 (3) static water level (feet) 43 below top of ground.
 (4) casing Plast. ballam (material) (depth)
 (size) if telescope see back.
 (5) screen 6' (length) 65' (depth to top)
1/2" Plast (size) (material)
 (6) pump 1/2 HP (HP) 15 (yield gpm)
elect (type power)
 (7) electric log no (yes or no)
 (organization running log)

description of formations encountered	from	to
Red clay	0	14
Red sand	14	36
Sand & gravel	36	43
Red sand & chalk	43	52
Sand & gravel	52	71


CODED

(8) how well bottom plugged
wooden plug
 DRILLERS REMARKS:
New house.

DEC 4 1972

If well telescopes please sketch and show depths.

GROUND LEVEL

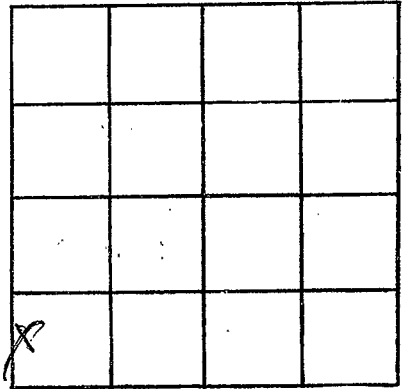

SECTION 5

Please indicate well location X.

ADDITIONAL INFORMATION

If more than one screen,
show locations of each on sketch.