

MISSISSIPPI
BOARD OF WATER COMMISSIONERS
416 North State Street
Jackson, Mississippi 39201

DUPLICATED

WATER WELL DRILLERS LOG

Pike
E 137
11-17-72

11-17 1972 J. J. Johnson & Sons Pike
date well completed firm name county well located

LANDOWNER:	description of formations encountered	from	to
<u>Richard Wilson</u>	<u>Red clay</u>	<u>0</u>	<u>30</u>
<u>R.R. McComb, Miss.</u> (mailing address)	<u>Red gravel</u>	<u>20</u>	<u>70</u>
	<u>Coarse sand & gravel</u>	<u>70</u>	<u>88</u>

LANDOWNER:

description of formations encountered

from

to

Richard Wilson

Red clay

0

30

R.R. McComb, Miss.
(mailing address)

Red gravel

20

70

Coarse sand & gravel

70

88

WELL LOCATION:

sec. 19 T-3 R-3

1/2 miles SE of McComb
(distance) (direction) (nearest town)

WELL PURPOSE: Home
(home, irrigation, municipal, industrial)

WELL COMPLETION DATA:

(1) diameter (inches) 4

(2) total depth (feet) 88

(3) static water level (feet) 75 below top of ground.

(4) casing plastic, 80
(material) (depth)

4 if telescope see back.
(size)

(5) screen 8, 80
(length) (depth to top)

4, plastic
(size) (material)

(6) pump 1/2, 10
(HP) (yield gpm)

elec
(type power)

(7) electric log no
(yes or no)

(organization running log)

(8) how well bottom plugged wood plug

DRILLERS REMARKS:


DEC 7 1972

DUPLICATED

MISS. DIV. OF WATER CONTROL

If well telescopes please sketch and show depths.

GROUND LEVEL

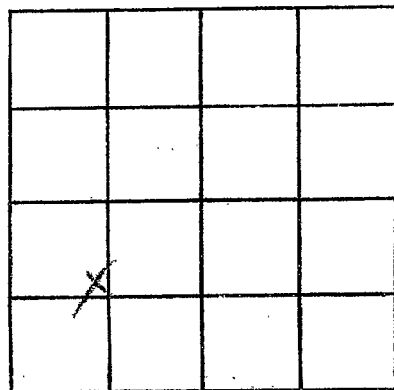

SECTION 19

Please indicate well location X.

ADDITIONAL INFORMATION

If more than one screen, show locations of each on sketch.