

Pike  
E 138  
11-3-72

MISSISSIPPI  
BOARD OF WATER COMMISSIONERS  
416 North State Street  
Jackson, Mississippi 39201

WATER WELL DRILLERS LOG **CODED**

11-3-72 date well completed 1972 firm name *Fitzmaurice Inc* county well located

LANDOWNER:  
*Robert Dillen*

| description of formations encountered | from | to |
|---------------------------------------|------|----|
|---------------------------------------|------|----|

RR. Magnolia Station -  
(mailing address)

|                                 |            |            |
|---------------------------------|------------|------------|
| <i>Red Clay</i>                 | <i>7</i>   | <i>20</i>  |
| <i>Red Sand</i>                 | <i>20</i>  | <i>80</i>  |
| <i>Red gravel</i>               | <i>80</i>  | <i>110</i> |
| <i>Coarse sand &amp; gravel</i> | <i>110</i> | <i>120</i> |

WELL LOCATION:  
sec. *32* T. *3* N. R. *8* E  
*2* miles *E* of *Farmington*  
(distance) (direction) (nearest town)

WELL PURPOSE:  
(home, irrigation, municipal, industrial)

WELL COMPLETION DATA:

- (1) diameter (inches) *4*
- (2) total depth (feet) *120*
- (3) static water level (feet) *75* below top of ground.
- (4) casing *Plastic, 112*,  
(material) (depth)  
*4* if telescope see back.  
(size)
- (5) screen *8*, *112*  
(length) (depth to top)  
*4*, *Plastic*  
(size) (material)
- (6) pump *1 1/2*, *10*  
(HP) (yield gpm)  
*Electric*  
(type power)
- (7) electric log *No*  
(yes or no)  
(organization running log)
- (8) how well bottom plugged *Wood peg*


**CODED**

DRILLERS REMARKS:

DEC 7 1972

If well telescopes please sketch and show depths.

GROUND LEVEL

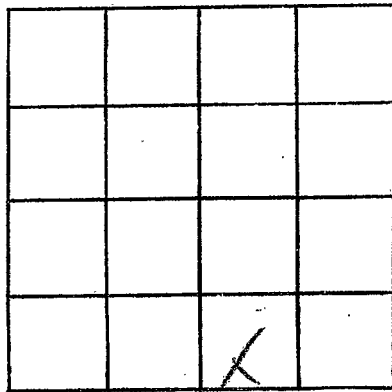

SECTION 52

Please indicate well location X:

ADDITIONAL INFORMATION

If more than one screen, show locations of each on sketch.