

Pike
E 139
11-30-72

MISSISSIPPI
BOARD OF WATER COMMISSIONERS
416 North State Street
Jackson, Mississippi 39201

CODED

WATER WELL DRILLERS LOG

11-30 1972 Fitzgerald & Welch Pike
date well completed firm name county well located

LANDOWNER:

Bobby Hall
R.R. M'Comb (mailing address)

WELL LOCATION:

sec. 22 T. 30 S. R. 8 E.
5 miles E of M'Comb
(distance) (direction) (nearest town)

WELL PURPOSE: Home & DAIRY
(home, irrigation, municipal, industrial)

WELL COMPLETION DATA:

- (1) diameter (inches) 4
- (2) total depth (feet) 151
- (3) static water level (feet) 10 below top of ground.
- (4) casing plastic, 131,
(material) (depth)
4 if telescope see back.
(size)
- (5) screen 20, 131
(length) (depth to top)
4, plastic
(size) (material)
- (6) pump 7 1/2, 125
(HP) (yield gpm)
elec
(type power)
- (7) electric log no
(yes or no)
(organization running log)
- (8) how well bottom plugged Wood plug

description of formations encountered

from to

<u>Red clay</u>	<u>0</u>	<u>20</u>
<u>Red sand</u>	<u>20</u>	<u>80</u>
<u>Red gravel</u>	<u>80</u>	<u>105</u>
<u>Red sand</u>	<u>105</u>	<u>128</u>
<u>Coarse fault gravel</u>	<u>128</u>	<u>151</u>


CODED

DRILLERS REMARKS:

JAN 28 1973

If well telescopes please sketch and show depths.

GROUND LEVEL

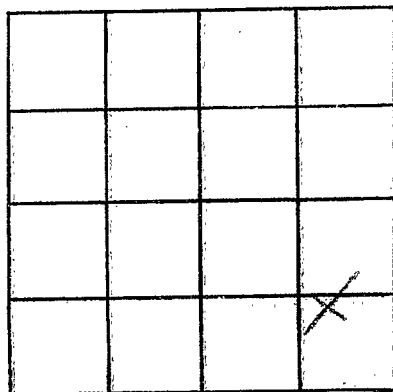

SECTION 22

Please indicate well location X.

ADDITIONAL INFORMATION

If more than one screen, show locations of each on sketch.