

PIKE Co.

6-73

E 143

E Log #125

MISSISSIPPI
BOARD OF WATER COMMISSIONERS
416 North State Street
Jackson, Mississippi 39201

COPIED

SEP 17 1973

WATER WELL DRILLERS LOG

MISS. Bd. of WATER CONTROL

June 1973 date well completed

Griner Drilling Service firm name

county well located

LANDOWNER: MISSISSIPPI FED.

description of formations encountered

from

to

Coop. - Adams Poultry
Plant - Macomb, well #2
(mailing address)

Top Soil	0	3
Coarse sand & gravel	3	128
Clay	128	176
Coarse sand	176	277
Clay	277	304
Sand	304	314
Clay	314	337
Sand	337	380
Clay, hard	380	630
Slight medium	630	704
Clay	704	711

WELL LOCATION: SW 1/4, SE 1/4

sec. 17 T. 3 N. R. 8 E

miles of (distance) (direction) of (nearest town)

WELL PURPOSE: (home, irrigation, municipal, industrial)


WELL COMPLETION DATA:

- (1) diameter (inches) 10 3/4"
- (2) total depth (feet) 700'
- (3) static water level (feet) 156' below top of ground.
- (4) casing B.I. 623' (material), (depth) 10 3/4" (size) if telescope see back.
- (5) screen 50' 650' (length), (depth to top) 8" 304 SS. - .0125" (size), (material)
- (6) pump 40 300 (HP), (yield gpm) Elect. (type power)
- (7) electric log Yes (yes or no) U.S. Geol. Survey (organization running log)
- (8) how well bottom plugged Back Wash Valve

DRILLERS REMARKS:

If well telescopes please sketch and show depths.

GROUND LEVEL

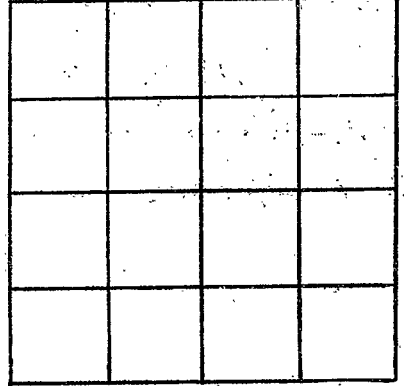

SECTION _____

Please indicate well location X.

ADDITIONAL INFORMATION

If more than one screen,
show locations of each on sketch.