

COPIED

MISSISSIPPI  
BOARD OF WATER COMMISSIONERS  
416 North State Street  
Jackson, Mississippi 39201

WATER WELL DRILLERS LOG

E 145  
PIKE  
7-23-73

7-23  
date well completed


1973 *Fitzgerald Well Co*  
firm name

*Reke*  
county well located

LANDOWNER:	description of formations encountered	from	to
<i>W. L. Williams</i>	<i>red clay hard sand cave level</i>	0	20
<i>R. R. Magnolia, Miss</i> (mailing address)		20	100
WELL LOCATION:		100	118
sec. <i>32</i> T. <i>3</i> (N) S R. <i>8</i> (E) <i>2</i> miles <i>E</i> of <i>Farmwood</i> (distance) (direction) (nearest town)			
WELL PURPOSE: <i>Home</i> (home, irrigation, municipal, industrial)			
WELL COMPLETION DATA:			
(1) diameter (inches) <i>4</i> (2) total depth (feet) <i>118</i> (3) static water level (feet) <i>90</i> below above top of ground.			
(4) casing <i>plaster</i> , <i>110</i> , (material) (depth) <i>4</i> If telescope see back. (size)			
(5) screen <i>8</i> , <i>110</i> (length) (depth to top) <i>4</i> , <i>plaster</i> (size) (material)			
(6) pump <i>1/2</i> , <i>10</i> (HP) (yield gpm) <i>Fla</i> (type power)			
(7) electric log <i>Y</i> (yes or no)			
(organization running log)			
(8) how well bottom plugged <i>covered by</i>			
DRILLERS REMARKS:			
	AUG 15 1973		

If well telescopes please sketch and show depths.

GROUND LEVEL

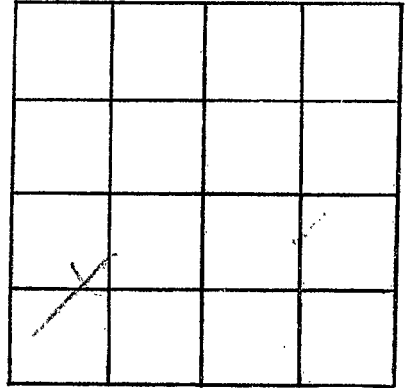

SECTION 32

Please indicate well location X.

ADDITIONAL INFORMATION

If more than one screen, show locations of each on sketch.