

E 146  
 PIKE  
 4-13-73

MISSISSIPPI  
 BOARD OF WATER COMMISSIONERS  
 416 North State Street  
 Jackson, Mississippi 39201

**CODED**

WATER WELL DRILLERS LOG

April 13 1973 Chesterheenes Pike  
 date well completed firm name county well located

LANDOWNER: William Combs  
Rt 2, McComb.

description of formations encountered	from	to
clay	0	12
Red Sand	12	33
gravel & sand	33	37
cherty sandy sandy clay	37	54
gravel & sand	54	60

(mailing address)

WELL LOCATION:  
 sec. 9 T 3 N R 8 E  
2 1/2 miles E of McComb  
 (distance) (direction) (nearest town)

WELL PURPOSE: Drain  
 (home, irrigation, municipal, industrial)

- WELL COMPLETION DATA:
- (1) diameter (inches) 4"
  - (2) total depth (feet) 60'
  - (3) static water level (feet) 33 below top of ground
  - (4) casing Heart Ballance  
 (material) (depth)
  - \_\_\_\_\_ if telescope see back.  
 (size)
  - (5) screen 6' 54'  
 (length) (depth to top)
  - 6" plastic  
 (size) (material)
  - (6) pump 1/2 Sub 15  
 (HP) (yield gpm)
  - steel  
 (type power)
  - (7) electric log no  
 (yes or no)
  - \_\_\_\_\_ (organization running log)


(8) how well bottom plugged  
wooden plug

DRILLERS REMARKS:  
old 2" wellhead

AUG 20 1973

If well telescopes please sketch and show depths.

GROUND LEVEL

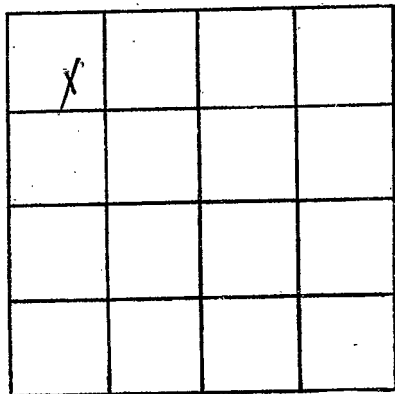

SECTION 9

Please indicate well location X.

ADDITIONAL INFORMATION

If more than one screen, show locations of each on sketch.