

E 147
PIKE
5-15-73

MISSISSIPPI
BOARD OF WATER COMMISSIONERS
416 North State Street
Jackson, Mississippi 39201

CODED

WATER WELL DRILLERS LOG

May 15 1973 Chester Keener Pike
date well completed firm name county well located

LANDOWNER: Reginald Martin
Rt. 2, M. Camb

description of formations
encountered

from to

Clay

0 16

(mailing address)

Sand & gravel

16 25

WELL LOCATION:

sec. 10 T. 3 N. R. 4 E
3 1/2 miles E-SE of M. Camb
(distance) (direction) (nearest town)

Slightly chert

25 37

Gravel & sand

37 53

WELL PURPOSE: Home
(home, irrigation, municipal, industrial)

WELL COMPLETION DATA:

CODED

- (1) diameter (inches) 4"
- (2) total depth (feet) 53
- (3) static water level (feet) 16 below top of ground
- (4) casing Plast Bottom (material) (depth)

if telescope see back.
(size)

- (5) screen 6' (length) 47' (depth to top)
4" (size) Plast (material)

- (6) pump old Murphy (HP) (yield gpm)
other (type power)

- (7) electric log No (yes or no)

(organization running log)


- (8) how well bottom plugged wooden plug

DRILLERS REMARKS: New house

AUG 20 1973

If well telescopes please sketch and show depths.

GROUND LEVEL

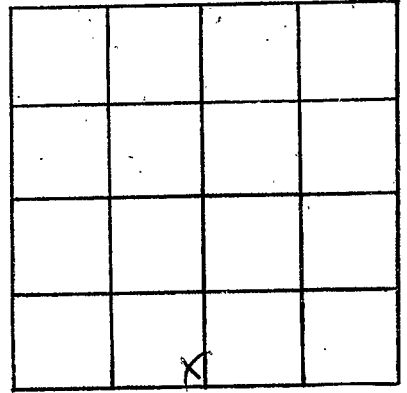

SECTION 10

Please indicate well location X.

ADDITIONAL INFORMATION

If more than one screen, show locations of each on sketch.