

E 148  
PIKE  
5-29-73

MISSISSIPPI  
BOARD OF WATER COMMISSIONERS  
416 North State Street  
Jackson, Mississippi 39201

**CODED**

WATER WELL DRILLERS LOG

May 29 1973 date well completed  
chester Reever firm name  
Pike county well located

LANDOWNER: Albert Jackson  
P.O. Magnolia  
(mailing address)

WELL LOCATION:  
sec. 35 T 3 N R 4 E  
1/2 miles E of Ferriday  
(distance) (direction) (nearest town)

WELL PURPOSE: Aerial  
(home, irrigation, municipal, industrial)

WELL COMPLETION DATA:

- (1) diameter (inches) 6"
- (2) total depth (feet) 114
- (3) static water level (feet) 89 below top of ground
- (4) casing Plast. Baltam (material) (depth)
- (5) screen 6' (length) 108' (depth to top)  
4" (size) Plast (material)
- (6) pump 1/2 HP (HP) 12 (yield gpm)  
Elet (type power)
- (7) electric log NO (yes or no)

if telescope see back.

(organization running log)

(8) how well bottom plugged  
wooden plug


DRILLERS REMARKS:  
New haul

description of formations encountered	from	to
Red clay	0	14
Sand	14	22
pink chalk	22	37
Red Sand	37	72
Sand gravel	72	89
loblolly	89	102
gravel	102	114

AUG 20 1973

If well telescopes please sketch and show depths.

GROUND LEVEL

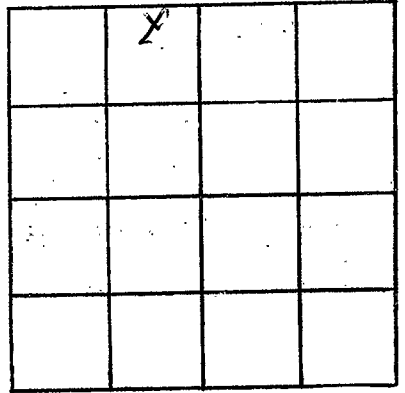

SECTION 35

Please indicate well location X.

ADDITIONAL INFORMATION

If more than one screen, show locations of each on sketch.