

PIKE
E151
10-29-73

MISSISSIPPI
BOARD OF WATER COMMISSIONERS
416 North State Street
Jackson, Mississippi 39201

CODED

WATER WELL DRILLERS LOG

10-29
date well completed

1973

Fitzgerald Well Co
firm name

Pike
county well located

LANDOWNER:

Wayne Williams
RR. Saint Michaels
(mailing address)

description of formations encountered:

from to

Red Clay	0	15
Red sand	15	45
Red Sand & clay	45	100
Coarse sand & gravel	100	110

WELL LOCATION:

sec. 25 T. 3 N. R. 8 E. W. 3
7 miles E of Mendenhall
(distance) (direction) (nearest town)

WELL PURPOSE:

Home
(home, irrigation, municipal, industrial)

WELL COMPLETION DATA:

- (1) diameter (inches) 4
- (2) total depth (feet) 110
- (3) static water level (feet) 45 below top of ground.
- (4) casing 102 (material) (depth)
if telescope see back.
(size)
- (5) screen 102 (length) (depth to top)
4 (size) (material)
- (6) pump 1/2 (HP) 12 (yield gpm)
EL (type power)
- (7) electric log 27 (yes or no)

(organization running log)

(8) how well bottom plugged sand

DRILLERS REMARKS:


CODED

NOV 15 1973

MISSISSIPPI
WATER BOARD

If well telescopes please sketch and show depths.

GROUND LEVEL

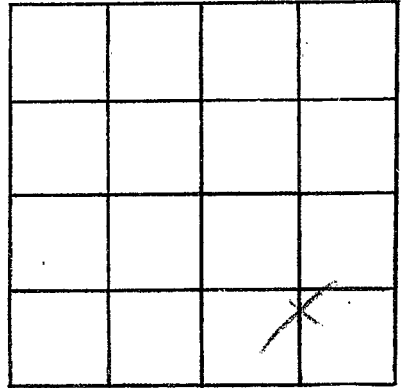

SECTION 25

Please indicate well location X.

ADDITIONAL INFORMATION

If more than one screen,
show locations of each on sketch.