

CODED

MISSISSIPPI BOARD OF WATER COMMISSIONERS
416 North State Street
Jackson, Mississippi 39201

WATER WELL DRILLERS LOG

PIKE
E 152
1-9-74

1-9 1974 Fieldwell Service Pike
date well completed firm name county well located

LANDOWNER:

Gene Deen
R.R. McComb, Miss.
(mailing address)

description of formations encountered

Red clay from 0 to 20
Coarse sand & subgravel from 20 to 108

WELL LOCATION:

sec 28 T-3 N R-30 E
2 miles E of McComb
(distance) (direction) (nearest town)

WELL PURPOSE:

Home
(home, irrigation, municipal, industrial)

CODED

WELL COMPLETION DATA:

- (1) diameter (inches) 4
- (2) total depth (feet) 108
- (3) static water level (feet) 75 below above top of ground.
- (4) casing plastic, 100,
(material) (depth)
4 if telescope see back.
(size)
- (5) screen 8, 100
(length) (depth to top)
4, plastic
(size) (material)
- (6) pump 1, 25
(HP) (yield gpm)
elec
(type power)
- (7) electric log No
(yes or no)

(organization running log)


(8) how well bottom plugged sand stop

DRILLERS REMARKS:

DEC 1974
JAN 9 1974

If well telescopes please sketch and show depths.

GROUND LEVEL

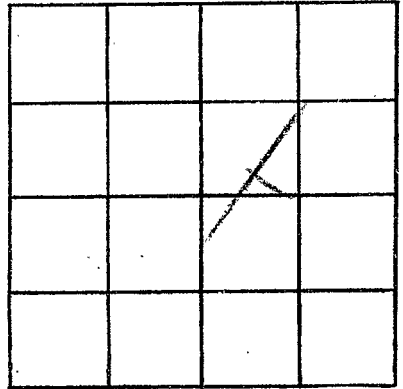

SECTION 28

Please indicate well location X.

ADDITIONAL INFORMATION

If more than one screen,
show locations of each on sketch.