

PIKE  
E 153  
3-18-74

MISSISSIPPI  
BOARD OF WATER COMMISSIONERS  
416 North State Street  
Jackson, Mississippi 39201

CODED

WATER WELL DRILLERS LOG

3-18 1974 *Fitzgerald Well Serv* *Pike*  
date well completed firm name county well located

LANDOWNER:

*C. H. Ainsworth*  
*R. M. Lomb*  
(mailing address)

description of formations encountered

from to

<i>Red Clay</i>	0	20
<i>Red Sand</i>	20	85
<i>Coarse sand gravel</i>	85	98

WELL LOCATION:

sec 2 T 3 N R 8 E  
1/2 miles E of M Lomb  
(distance) (direction) (nearest town)

WELL PURPOSE:

*Home*  
(home, irrigation, municipal, industrial)

WELL COMPLETION DATA:

- (1) diameter (inches) 4
- (2) total depth (feet) 98
- (3) static water level (feet) 60 below above top of ground.
- (4) casing Plastic, 90'  
(material) (depth)  
4 If telescope see back.  
(size)
- (5) screen 8, 90'  
(length) (depth to top)  
4, Plastic  
(size) (material)
- (6) pump 3/4, 18  
(HP) (yield gpm)  
Electric  
(type power)
- (7) electric log Yes  
(yes or no)  
(organization running log)
- (8) how well bottom plugged Seal floor


CODED

DRILLERS REMARKS:

MAY 1 1974

If well telescopes please sketch and show depths.

GROUND LEVEL

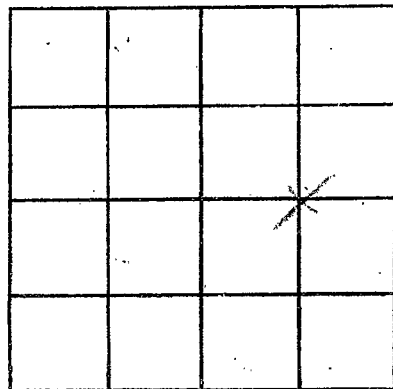

SECTION 7

Please indicate well location X.

ADDITIONAL INFORMATION

If more than one screen, show locations of each on sketch.

41