

PIKE
E 154
4/74

MISSISSIPPI
BOARD OF WATER COMMISSIONERS
416 North State Street
Jackson, Mississippi 39201 **CODED**

WATER WELL DRILLERS LOG

J. T. Colvinson + Son *Pike*
date well completed 19 firm name county well located

LANDOWNER:
Gene M. Carley
Madrasville
(mailing address)

description of formations encountered	from	to
<i>Clay</i>	<i>0</i>	<i>25</i>
<i>Red shale</i>	<i>25</i>	<i>60</i>
<i>Sand</i>	<i>60</i>	<i>74</i>

WELL LOCATION:
sec. 31 T. 3 N. R. 2 E
3 miles S of Farmwood
(distance) (direction) (nearest town)

WELL PURPOSE:
(home, irrigation, municipal, industrial)

- WELL COMPLETION DATA:
- (1) diameter (inches) 4
 - (2) total depth (feet) 94
 - (3) static water level (feet) 70 below above top of ground.
 - (4) casing 21 88
(material) (depth)
if telescope see back.
 - (5) screen 6 88
(length) (depth to top)
4 21
(size) (material)
 - (6) pump 8 8
(HP) (yield gpm)
electric
(type power)
 - (7) electric log
(yes or no)

(organization running log)
 - (8) how well bottom plugged wood


CODED

RECORDED
APR 17 1974

DRILLERS REMARKS:

If well telescopes please sketch and show depths.

GROUND LEVEL

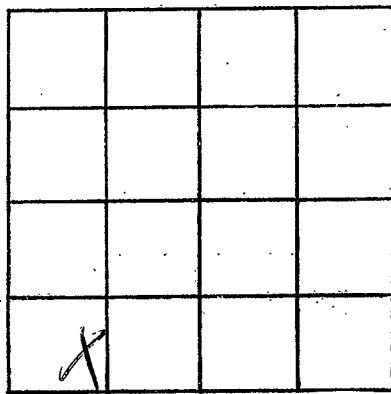

SECTION 31

Please indicate well location X.

ADDITIONAL INFORMATION

If more than one screen,
show locations of each on sketch.