

PIKE
E156
6-20-74

MISSISSIPPI
BOARD OF WATER COMMISSIONERS CODED
416 North State Street
Jackson, Mississippi 39201

WATER WELL DRILLERS LOG

6-20-74 date well completed
Fitzgerald L.L. firm name
Pike county well located

LANDOWNER:

Dickerson-Bowden
P.R. McComb Miss.
(mailing address)

description of formations encountered

from to

Red clay	0	20
Red sand	20	95
Coarse sand	95	130
White chalk	130	178
Coarse sand & gravel	178	195

WELL LOCATION:

sec. 2 T. 1 N. R. 8 E.
3 miles E of McComb
(distance) (direction) (nearest town)

CODED

WELL PURPOSE: Home
(home, irrigation, municipal, industrial)

WELL COMPLETION DATA:

- (1) diameter (inches) 4
- (2) total depth (feet) 195
- (3) static water level (feet) 96 below above top of ground.
- (4) casing Plastic 180, (material) (depth)
4 (size) if telescope see back.
- (5) screen 15, 180 (length) (depth to top)
4 (size) Plastic (material)
- (6) pump 5, 100 (HP) (yield gpm)
Elec (type power)
- (7) electric log no (yes or no)
(organization running log)
- (8) how well bottom plugged bad


RECEIVED
JUL 10 1974

DRILLERS REMARKS:

MISS. BD. OF WATER COMM

If well telescopes please sketch and show depths.

GROUND LEVEL

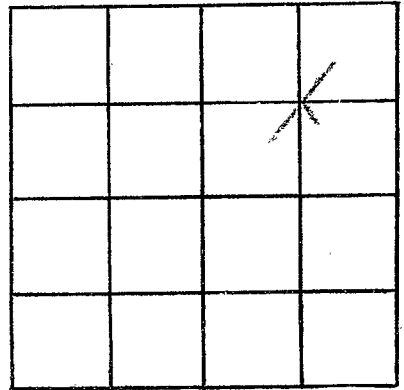

SECTION 21

Please indicate well location X.

ADDITIONAL INFORMATION

If more than one screen,
show locations of each on sketch.