

MISSISSIPPI
BOARD OF WATER COMMISSIONERS
416 North State Street
Jackson, Mississippi 39201

WATER WELL DRILLERS LOG

PIKE
E 158
8/6/79

6 Aug 1979 date well completed J.T. Cunningham firm name Pike county well located

LANDOWNER: McCarlie

description of formations encountered

from to

Caro McCarlie
McCarlie
(mailing address)

clay	0	20
clay & silt	20	50
sand & silt	50	75
sand & clay	75	85
sand	85	132

WELL LOCATION:

sec. 313 N 8 E
S W
1 miles S of Farmwood
(distance) (direction) (nearest town)

WELL PURPOSE:
(home, irrigation, municipal, industrial)

WELL COMPLETION DATA:

- (1) diameter (inches) 4
- (2) total depth (feet) 132
- (3) static water level (feet) 70 below above top of ground.
- (4) casing PI, 118,
(material) (depth)
(size) if telescope see back.
- (5) screen 24, 118
(length) (depth to top)
4, PI
(size) (material)
- (6) pump 5, 7.0
(HP) (yield gpm)
elct
(type power)
- (7) electric log _____
(yes or no)

(organization running log)

(8) how well bottom plugged wood

DRILLERS REMARKS:

CODED


RECEIVED
FILED
18

OCT 17 1979

MISS. BD. OF WATER COMMISSIONERS

If well telescopes please sketch and show depths.

GROUND LEVEL

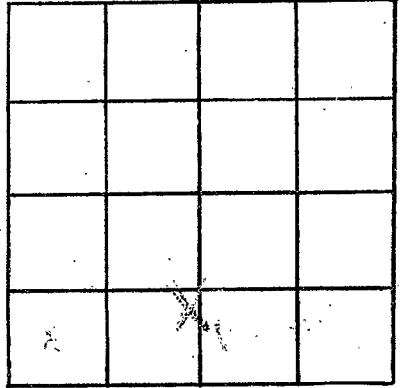

SECTION 31

Please indicate well location X.

ADDITIONAL INFORMATION

If more than one screen, show locations of each on sketch.