

PIKE  
E 159  
7-25-74

MISSISSIPPI  
BOARD OF WATER COMMISSIONERS  
416 North State Street  
Jackson, Mississippi 39201

CODED

WATER WELL DRILLERS LOG

July 25 1974 Chester Keene Pike  
date well completed firm name county well located

LANDOWNER: Buss Supply Co  
McComb  
(mailing address)

description of formations encountered	from	to
clay & gravel	0	20
big gravel sand	20	63
small gravel sand	63	114

WELL LOCATION:  
sec. 17 T 3 N R 9 E  
2 1/2 miles S. SE of McComb  
(distance) (direction) (nearest town)

WELL PURPOSE: Industrial  
(home, irrigation, municipal, industrial)

WELL COMPLETION DATA:

(1) diameter (inches) 16"

(2) total depth (feet) 115

(3) static water level (feet) 88 below above top of ground.

(4) casing Plast Ballast  
(material) (depth)

\_\_\_\_\_ If telescope see back.  
(size)

(5) screen 6' 109  
(length) (depth to top)

1/4" Plast  
(size) (material)

(6) pump 3/4 Sub 15  
(HP) (yield gpm)

Elect  
(type power)

(7) electric log NO  
(yes or no)

\_\_\_\_\_ (organization running log)

(8) how well bottom plugged wooden plug


DRILLERS REMARKS:  
new location for well

RECEIVED  
MAY 31 1974

MISS. Bd. OF WATER COMM.

If well telescopes please sketch and show depths.

GROUND LEVEL

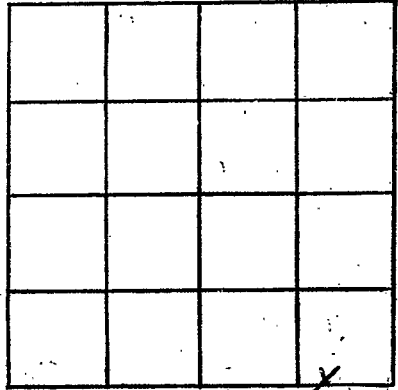

SECTION 17

Please indicate well location X.

ADDITIONAL INFORMATION

If more than one screen, show locations of each on sketch.