

PIKE
E 160
4-30-79

MISSISSIPPI
BOARD OF WATER COMMISSIONERS
416 North State Street
Jackson, Mississippi 39201

CODED

WATER WELL DRILLERS LOG

April 30 1979 Chester Keever Pike
date well completed firm name county well located


LANDOWNER: D.D. Sturgis Rt 2, McComb	description of formations encountered	from	to
(mailing address)	Red clay	0	18
WELL LOCATION: sec. 17 T. 3 N R. 8 E 1 1/2 miles ESE of McComb	Red sand	18	46
(distance) (direction) (nearest town)	Sand & gravel	46	70
WELL PURPOSE: Home (home, irrigation, municipal, industrial)	White chalk	70	89
WELL COMPLETION DATA: (1) diameter (inches) 4"	Small gravel sand	89	98
(2) total depth (feet) 98			
(3) static water level (feet) 70 below top of ground.			
(4) casing: Plast Bottom (material) (depth)			
(5) screen: 6' 9" (length) (depth to top)			
(6) pump: 1/2 HP (HP) 1.5 (yield gpm)			
(7) electric log NO (yes or no)			
(8) how well bottom plugged: Cracked plug			
DRILLERS REMARKS: well filled with sand & mud			

DECEMBER 15 1979
OCT 31 1979

MISS. BD. OF WATER COMMISSIONERS

If well telescopes please sketch and show depths.

GROUND LEVEL

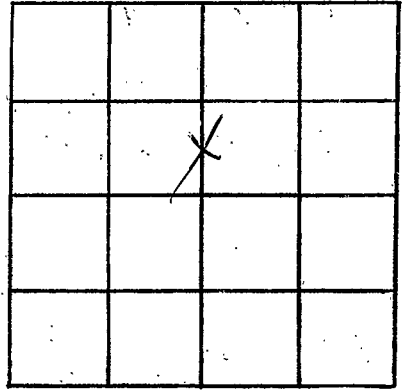

SECTION 17

Please indicate well location X.

ADDITIONAL INFORMATION

If more than one screen, show locations of each on sketch.