

PIKE  
E 161  
5-7-79

MISSISSIPPI  
BOARD OF WATER COMMISSIONERS  
416 North State Street  
Jackson, Mississippi 39201

CODED

WATER WELL DRILLERS LOG

May 7 1974 Chester Reeves Pike  
date well completed firm name county well located

LANDOWNER: Charles Hamel  
AT: Mr. Cornub (mailing address)  
description of formations encountered from to  
Clay gravel 0 16  
sand gravel 16 54  
chert & sand 54 78  
small gravel & sand 78 85

WELL LOCATION:  
sec. 32 T. 3 N R. 8 E  
1 miles SE of Raymond  
(distance) (direction) (nearest town)

WELL PURPOSE: House  
(home, irrigation, municipal, industrial)

WELL COMPLETION DATA:  
(1) diameter (inches) 4"  
(2) total depth (feet) 85  
(3) static water level (feet) 35 below top of ground.  
(4) casing Plast ballast  
(material) (depth)  
(size) If telescope see back.  
(5) screen 6' 79'  
(length) (depth to top)  
4" Plast  
(size) (material)  
(6) pump 1/2 15  
(HP) (yield gpm)  
elect  
(type power)  
(7) electric log no  
(yes or no)  
(organization running log)


(8) how well bottom plugged  
wooden plug  
DRILLERS REMARKS:  
New location

RECEIVED  
OCT 30 1974

MISS. BD. OF WATER COMM.

If well telescopes please sketch and show depths.

GROUND LEVEL

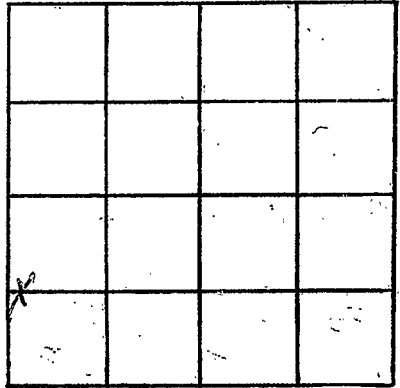

SECTION 32

Please indicate well location X.

ADDITIONAL INFORMATION

If more than one screen, show locations of each on sketch.