

PIKE
E 162
10/29/74

MISSISSIPPI
BOARD OF WATER COMMISSIONERS
416 North State Street
Jackson, Mississippi 39201

CODED

WATER WELL DRILLERS LOG

28 Oct 1974 Ames Park Well Co. Pike
date well completed year firm name county well located

LANDOWNER: McCarlie
Genl. McCarlie
McCarlie
(mailing address)

description of formations encountered	from	to
<u>clay</u>	<u>0</u>	<u>10</u>
<u>silt</u>	<u>10</u>	<u>108</u>
<u>clay</u>	<u>108</u>	<u>170</u>
<u>sand</u>	<u>170</u>	<u>187</u>

WELL LOCATION:
sec. 31 T. 3 N. R. 8 E
2 miles S of Florescent
(distance) (direction) (nearest town)

WELL PURPOSE:
(home, irrigation, municipal, industrial)

- WELL COMPLETION DATA:
- (1) diameter (inches) 4
- (2) total depth (feet) 187
- (3) static water level (feet) 10 ^{below} above top of ground.
- (4) casing PI, 158,
(material) (depth)
PI if telescope see back.
(size)
- (5) screen 24, 158
(length) (depth to top)
4, PI
(size) (material)
- (6) pump _____ (HP) _____ (yield gpm)
(type power) Flow meter
- (7) electric log About 12:00 P.M.
(yes or no)
- (organization running log) _____
- (8) how well bottom plugged _____

CODED


DRILLERS REMARKS: _____

RECEIVED
DEC - 8 1974

MISS. DEPT. OF WATER CONTROL

If well telescopes please sketch and show depths.

GROUND LEVEL

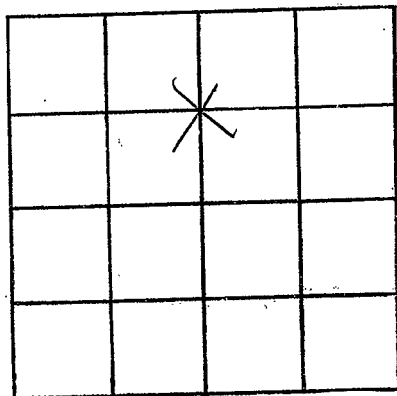

SECTION 31

Please indicate well location X.

ADDITIONAL INFORMATION

If more than one screen, show locations of each on sketch.