

PIKE  
E164  
11-18-74

MISSISSIPPI  
BOARD OF WATER COMMISSIONERS  
416 North State Street  
Jackson, Mississippi 39201

WATER WELL DRILLERS LOG

Pike

Nov. 18

1974 Chester Rimmer

date well completed

firm name-

county well located


LANDOWNER:	description of formations encountered	from	to
Martin Noah - Pt 2, box 253 M. G. Leavelle (mailing address)			
WELL LOCATION: sec. 10 T. 3 N. R. 8 E. 130 3 1/2 miles East of M. G. Leavelle (distance) (direction) (nearest town)	Red Clay	0	18
WELL PURPOSE: home (home, irrigation, municipal, industrial)	Red sand	18	52
WELL COMPLETION DATA:	small gravel	52	56
(1) diameter (inches) 4"	White Chalk	56	74
(2) total depth (feet) 82	small gravel & sand	74	82
(3) static water level (feet) 56 below top of ground.			
(4) casing plastic, bottom (material) (depth)			
(5) screen 6" 76' (length) (depth to top)			
(6) pump 1/2 HP 6 (type power) (yield gpm)			
(7) electric log no (yes or no)			
(8) how well bottom plugged Wooden plug			
DRILLERS REMARKS: new house site			

RECEIVED

MAR 31 1975

If well telescopes please sketch and show depths.

GROUND LEVEL

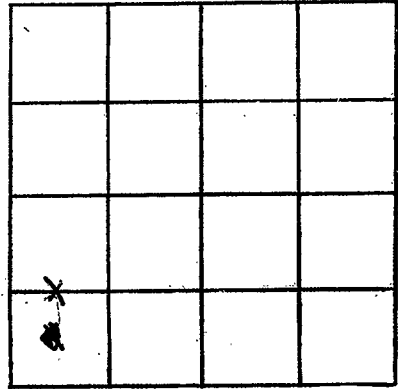

SECTION 10

Please indicate well location X.

ADDITIONAL INFORMATION

If more than one screen, show locations of each on sketch.