

Pike
E167
7-30-75

MISSISSIPPI
 BOARD OF WATER COMMISSIONERS
 416 North State Street
 Jackson, Mississippi 39201

DED

CODED


WATER WELL DRILLERS LOG

7-30 1975 Fitzgerald Well Serv Pike
 date well completed firm name county well located

LANDOWNER:	description of formations encountered	from	to
<u>Lennie Smith</u>	<u>Red Clay</u>	<u>0</u>	<u>20</u>
<u>R.B. McComb, Jr.</u> (mailing address)	<u>Red Sand</u>	<u>20</u>	<u>106</u>
WELL LOCATION: sec. <u>35</u> T- <u>30</u> S R- <u>8E</u> ¹³⁴	<u>Red Sand</u>	<u>100</u>	<u>125</u>
<u>7</u> miles <u>E</u> of <u>McComb</u> (distance) (direction) (nearest town)	<u>Coarse sand & gravel</u>	<u>125</u>	<u>137</u>
WELL PURPOSE: <u>Home</u> (home, irrigation, municipal, industrial)			
WELL COMPLETION DATA:			
(1) diameter (inches) <u>4</u>			
(2) total depth (feet) <u>137</u>			
(3) static water level (feet) <u>85</u> below top of ground.			
(4) casing <u>PVC</u> <u>129</u> (material) (depth)			
<u>4</u> If telescope see back. (size)			
(5) screen <u>8</u> <u>129</u> (length) (depth to top)			
<u>4</u> <u>PVC</u> (size) (material)			
(6) pump <u>1/2</u> <u>10</u> (HP) (yield gpm)			
<u>elec</u> (type power)			
(7) electric log <u>no</u> (yes or no)			
(organization running log)			
(8) how well bottom plugged <u>Seal Shell</u>			
DRILLERS REMARKS:	AUG 1 1975		

If well telescopes please sketch and show depths.

GROUND LEVEL

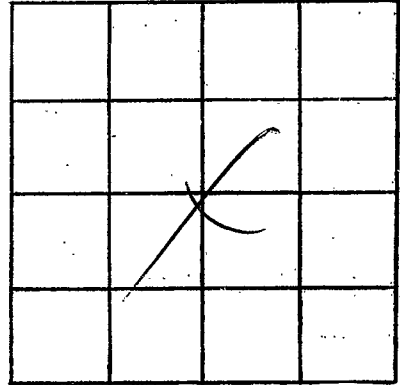

SECTION 35

Please indicate well location X.

ADDITIONAL INFORMATION

If more than one screen, show locations of each on sketch.