

PIKE
E 171
11/8/77

MISSISSIPPI
BOARD OF WATER COMMISSIONERS
416 North State Street
Jackson, Mississippi 39201

CODES

WATER WELL DRILLERS LOG

11-8 1977 Fitzgerald Well Service Pike
date well completed firm name county well located

LANDOWNER:	description of formations encountered	from	to
<u>Bobby Hall</u>	<u>Red clay</u>	<u>0</u>	<u>20</u>
<u>P.R. McComb, Miss.</u> (mailing address)	<u>Red sand & gravel</u>	<u>20</u>	<u>126</u>
	<u>Coarse sand & gravel</u>	<u>126</u>	<u>149</u>
WELL LOCATION:			
sec. <u>22</u> T. <u>3</u> (N) S R. <u>8</u> (E) W			
<u>5</u> miles <u>E</u> of <u>McComb</u> (distance) (direction) (nearest town)			
WELL PURPOSE: <u>Municipal</u> (home, irrigation, municipal, industrial)			
WELL COMPLETION DATA:			
(1) diameter (inches) <u>4</u>			
(2) total depth (feet) <u>149</u>			
(3) static water level (feet) <u>95</u> below above top of ground.			
(4) casing <u>PVC</u> , <u>129</u> (material) (depth) <u>4</u> if telescope see back. (size)			
(5) screen <u>20</u> , <u>129</u> (length) (depth to top) <u>4</u> , <u>PVC</u> (size) (material)			
(6) pump <u>5</u> , <u>95</u> (HP) (yield gpm) <u>Electric</u> (type power)			
(7) electric log <u>no</u> (yes or no) (organization running log)			
(8) how well bottom plugged <u>Sand block</u>			
DRILLERS REMARKS:			

CODES


RECEIVED

DEC 28 1977

MISS. BD. OF WATER COMM

If well telescopes please sketch and show depths.

GROUND LEVEL

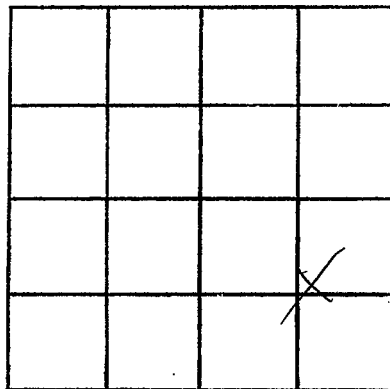

SECTION 22

Please indicate well location X.

ADDITIONAL INFORMATION

If more than one screen,
show locations of each on sketch.