

**PIKE**  
**E 174**  
**2180**  
**Elog #145**  
**2-**

MISSISSIPPI  
 BOARD OF WATER COMMISSIONERS  
 416 North State Street  
 Jackson, Mississippi 39201

**CODED**

**WATER WELL DRILLERS LOG**

19 **80** **GRINER DRILLING CO.** **PIKE**  
 date well completed firm name county well located

**LANDOWNER: FRIENDSHIP**  
**WATER ASSOC.**  
**Well No. 2**  
 (mailing address)  
**WELL LOCATION: NE 1/4 SW**  
 sec. 5 T. 3 (N) R. 8 (E)  
 S W  
 \_\_\_\_\_ miles \_\_\_\_\_ of \_\_\_\_\_  
 (distance) (direction) (nearest town)  
**WELL PURPOSE:**  
 (home, irrigation, municipal, industrial)

description of formations encountered	from	to
TOP SOIL	0	3
Red CLAY	3	12
SAND + GRAVEL	12	118
CLAY	118	210
SAND	210	252
CLAY	252	268
SAND	268	288
CLAY	288	540
SAND	540	670
CLAY	670	687

**CODED**

**WELL COMPLETION DATA:**  
 (1) diameter (inches) 10 3/4"  
 (2) total depth (feet) 667'  
 (3) static water level (feet) 218 below above top of ground.  
 (4) casing Steel 600'  
 (material) (depth)  
10 3/4" If telescope see back.  
 (size)  
 (5) screen 40 610' + 639'  
 (length) (depth to top)  
6" 304 S.S. (1.006 x .007)  
 (size) (material)  
 (6) pump 30 200  
 (HP) (yield gpm)  
Elect.  
 (type power)  
 (7) electric log Yes  
 (yes or no)  
MGS  
 (organization running log)  
 (8) how well bottom plugged BACK  
WITH WIRE

DEPT. OF NATURAL RESOURCES  
 BUREAU OF LAND & WATER RESOURCES


**JUN 25 1980**

**RECEIVED**

**DRILLERS REMARKS:**

If well telescopes please sketch and show depths.

GROUND LEVEL

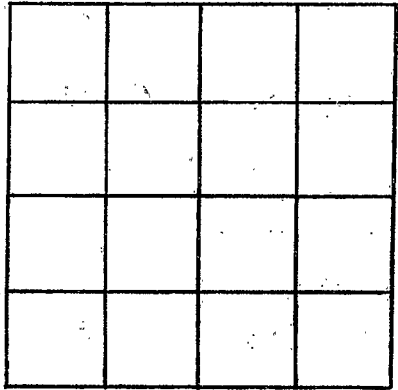

SECTION \_\_\_\_\_

Please indicate well location X:

ADDITIONAL INFORMATION

If more than one screen, show locations of each on sketch.