

MISSISSIPPI DEPARTMENT OF NATURAL RESOURCES

Bureau of Land and Water Resources

Southport Mall

P.O. Box 10631

Jackson, Mississippi 39209

WATER WELL DRILLERS LOG

CODED

PIKE
E E 176
11/22/83

Griner Drilling Service, Inc.

Pike

11-22-83
date well completed

Griner Drilling Service, Inc.
firm name

Pike
county well located

LANDOWNER:

ANR Production
111 Capitol Street
Jackson, MS 39201

(mailing address)

description of formations encountered

from

to

sand

0

105

sand

105

147

gravel

147

210

clay

210

315

streaked

315

357

sand, gravel

357

378

sand, clay

378

400

WELL LOCATION: 2140'N + 2131'W

Sec. 12 T. 30N R. 8 E SE 1/4

No. 1 C. R. Donald McComb

(distance) miles (direction) of (nearest town)

WELL PURPOSE: oilfield supply

(home, irrigation, municipal, industrial)

WELL COMPLETION DATA:

(1) diameter (inches) 4"

(2) total depth (feet) 400'

(3) static water level (feet) 75' below top of ground.

(4) casing steel 400' (material), (depth)

2" (size) if telescope see back.

(5) screen 42' 378' (length), (depth to top)

4" perforated (size), (material)

(6) pump — 70 (HP), (yield gpm)

AC (type power)

(7) electric log (yes or no)

(organization running log)

(8) how well bottom plugged Orange peel

DRILLERS REMARKS:

CODED


DEPT. OF NATURAL RESOURCES
BUREAU OF LAND & WATER RESOURCES

DEC - 7 1983

RECEIVED

If well telescopes please sketch and show depths.

GROUND LEVEL

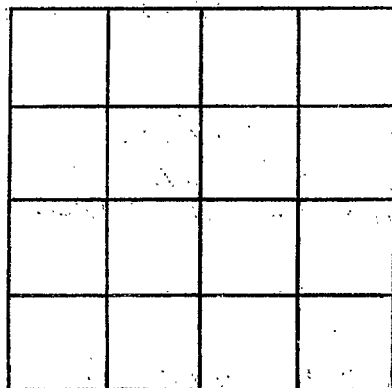

SECTION 12

Please indicate well location X.

ADDITIONAL INFORMATION

If more than one screen, show locations of each on sketch.