

MISSISSIPPI DEPARTMENT OF NATURAL RESOURCES

Bureau of Land and Water Resources

Southport Mall

P.O. Box 10631

Jackson, Mississippi 39209

WATER WELL DRILLERS LOG

CODED

E 187  
 PIKE CO  
 12-12-83

12-12-84<sup>3</sup> Griner Drilling Service, Inc. Pike  
 date well completed firm name county well located

LANDOWNER:  
 Marion Drilling  
 P.O. Box 3027  
 Daphne, Ala.  
 (mailing address)

description of formations encountered	from	to
sand, gravel	0	70
chalk	70	105
sand, pea gravel	105	210
chalk	210	231
NW, NW		

WELL LOCATION: 711° 54' 57" E  
 sec. 32 T 3 N R 8 E NW 1/4  
 No. 1 Kenzie Fernwood  
 (distance) (direction) (nearest town)

WELL PURPOSE: oil field supply  
 (home, irrigation, municipal, industrial)

WELL COMPLETION DATA:

(1) diameter (inches) 3"  
 (2) total depth (feet) 231'  
 (3) static water level (feet) 45' below top of ground.  
 (4) casing Steel 210' (material) (depth)  
 3" (size) if telescope see back.  
 (5) screen 42' 168' (length) (depth to top)  
 3" perforated (size) (material)  
 (6) pump - 75 (HP) (yield gpm)  
 AC (type power)  
 (7) electric log - (yes or no)  
 (organization running log)  
 (8) how well bottom plugged orange peel

DRILLERS REMARKS:

DEPT. OF NATURAL RESOURCES  
 BUREAU OF LAND & WATER RESOURCES


JAN 27 1984

RECEIVED

If well telescopes please sketch and show depths.

GROUND LEVEL

21 1/2  
1320  
140

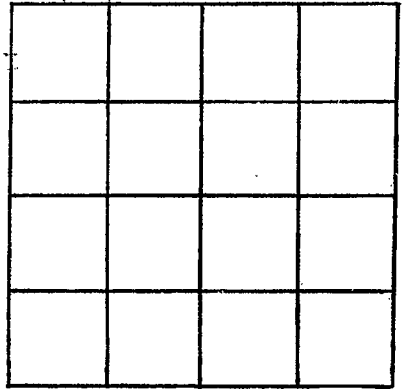

SECTION 32

Please indicate well location X.

ADDITIONAL INFORMATION

If more than one screen, show locations of each on sketch.