

MISSISSIPPI DEPARTMENT OF NATURAL RESOURCES

Bureau of Land and Water Resources

Southport Mall

P.O. Box 10631

Jackson, Mississippi 39209

CODED

WATER WELL DRILLERS LOG

Pike
E188
2-12-84

date well completed 2-12-84 firm name Griner Drilling Service, Inc. county well located Pike

LANDOWNER:	description of formations encountered	from	to
<u>ANR. Production Co.</u> <u>111 Capitol Bldg</u> <u>Suite 400</u> <u>Jackson, MS 39201</u> <small>(mailing address)</small>			
<u>WELL LOCATION: 2200'S + 2100'W</u> <u>sec. 12 T. 3 N. R. 8 E. 10 or</u> <u>No. 1 Williams Friendship Church</u> <u>B.R. Williams</u> <small>(distance) miles (direction) of (town)</small>	<u>gravel</u>	<u>21</u>	<u>63</u>
<u>WELL PURPOSE: oilfield supply</u> <small>(home, irrigation, municipal, industrial)</small>	<u>clay, rock</u>	<u>63</u>	<u>84</u>
<u>WELL COMPLETION DATA:</u>	<u>sand, gravel</u>	<u>84</u>	<u>126</u>
(1) diameter (inches) <u>4"</u>	<u>chalk</u>	<u>126</u>	<u>147</u>
(2) total depth (feet) <u>462'</u>	<u>sand</u>	<u>147</u>	<u>210</u>
(3) static water level (feet) <u>80'</u> <small>(below above top of ground)</small>	<u>chalk</u>	<u>210</u>	<u>315</u>
(4) casing <u>Steel</u> , <u>462'</u> <small>(material) (depth)</small>	<u>streaked</u>	<u>315</u>	<u>357</u>
<u>4"</u> if telescope see back. <small>(size)</small>	<u>chalk</u>	<u>357</u>	<u>399</u>
(5) screen <u>42'</u> , <u>420'</u> <small>(length) (depth to top)</small>	<u>streaked</u>	<u>399</u>	<u>420</u>
<u>4"</u> , <u>perforated</u> <small>(size) (material)</small>	<u>sand</u>	<u>420</u>	<u>462</u>
(6) pump <u>—</u> , <u>80</u> <small>(HP) (yield gpm)</small>			
<u>AC</u> <small>(type power)</small>			
(7) electric log <u>—</u> <small>(yes or no)</small>			
<u>—</u> <small>(organization running log)</small>			
(8) how well bottom plugged <u>orange peel</u>			

DEPT. OF NATURAL RESOURCES
BUREAU OF LAND & WATER RESOURCES


FEB 17 1984

RECEIVED

DRILLERS REMARKS:

If well telescopes please sketch and show depths.

GROUND LEVEL

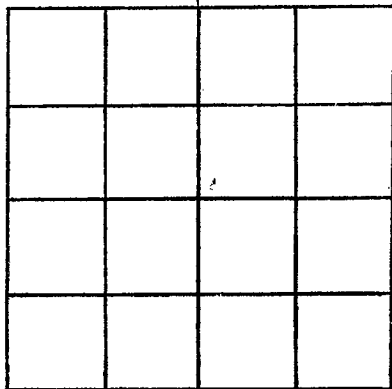

SECTION _____

Please indicate well location X.

ADDITIONAL INFORMATION

If more than one screen,
show locations of each on sketch.